
ROBERS & BOYD, INC.
CONSULTING ENGINEERS & LAND SURVEYORS
PHONE (414) 763-2652 116 E. CHESTNUT ST. BURLINGTON, WIS. 53105

PLAT OF SURVEY
FOR
A. T. KOLTON

Lot 20, Lake Geneva Beach, a subdivision located in the Southwest 1/4 of Section 21, T1N., R17E., of the 4th P.M., Township of Linn, County of Walworth, State of Wisconsin.

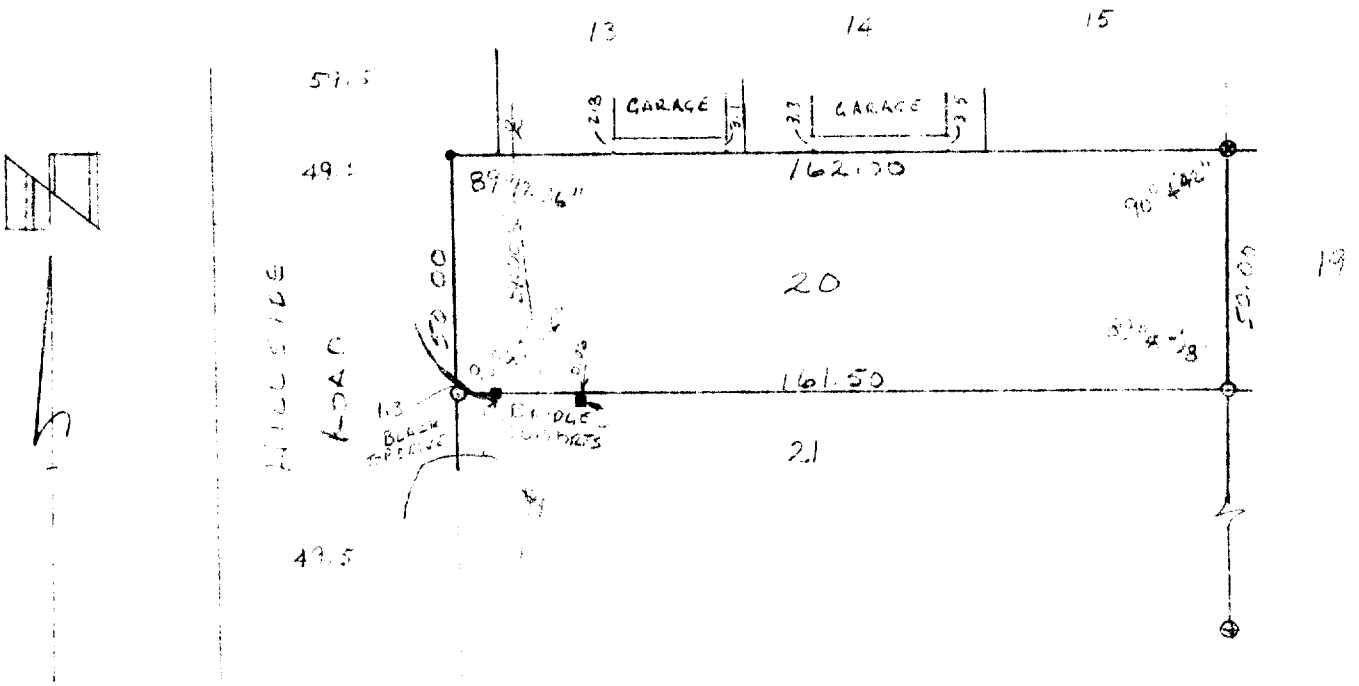

- LEGEND -
• FOUND 1" IRON PIPE
⊕ FOUND CONCRETE MONUMENT
○ SET 1"x24" IRON PIPE
SCALE 1" = 40'

WISCONSIN
KENNETH R. REESMAN
S-1351
BURLINGTON
WIS.
LAND SURVEYOR

I HEREBY CERTIFY THAT WE HAVE SURVEYED THE LANDS DESCRIBED ABOVE ACCORDING TO OFFICIAL RECORDS AND THAT THE PLAT DRAWN HEREON IS A CORRECT REPRESENTATION OF SAID SURVEY.

WIS. REG. LAND SURVEYOR

DATE 8/17/77

JOB NO. 7771

K & E 10-7155 250-4-76

117-544