
KOLB LAND CONSULTING, INC.

LAND SURVEYING · SUBDIVIDING · LAND PLANNING

LAKE GENEVA, WISCONSIN 53147 WHITEWATER, WISCONSIN 53190

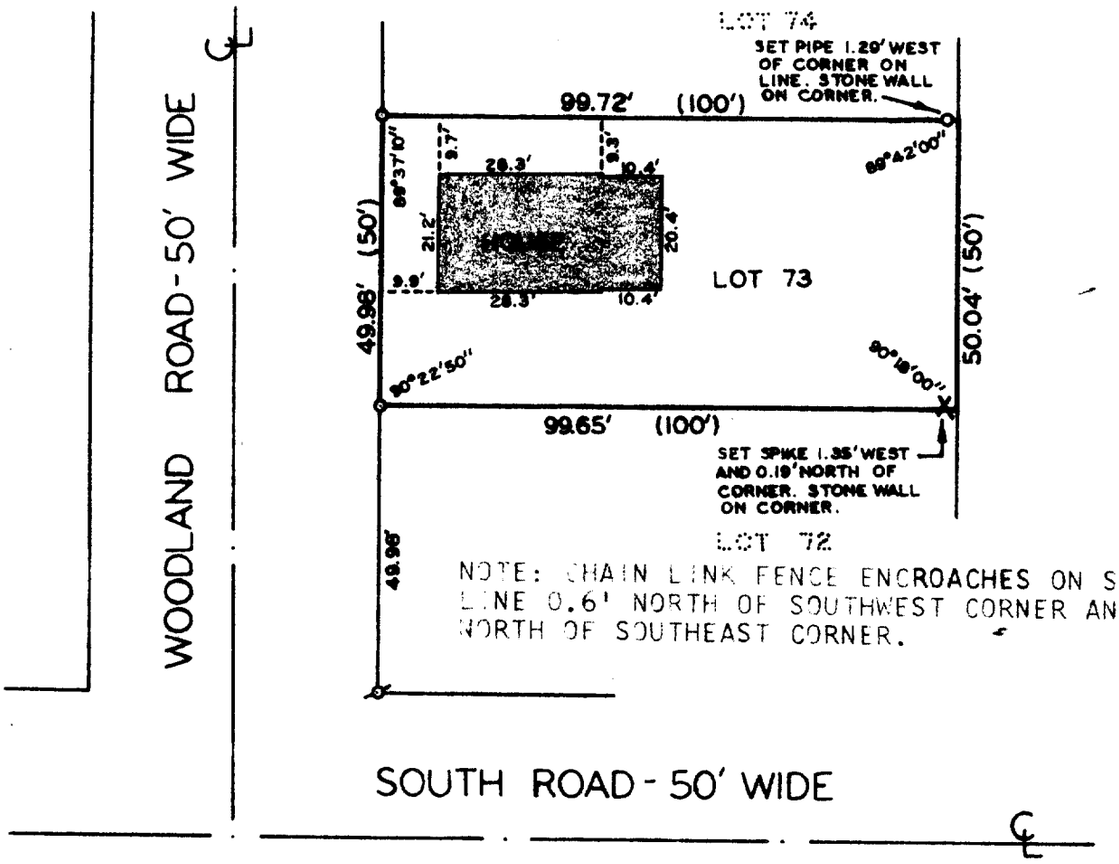

NOTE: CHAIN LINK FENCE ENCROACHES ON SOUTH LINE 0.6' NORTH OF SOUTHWEST CORNER AND 0.3' NORTH OF SOUTHEAST CORNER.

PLAT OF SURVEY OF

LOT 73, LAKE GENEVA HIGHLANDS, A SUBDIVISION LOCATED IN SECTION 8, TOWN 1 NORTH, RANGE 17 EAST, WALWORTH COUNTY, WISCONSIN.

ORDERED BY: ALLEN SCHNEIDER
1013 EVA LANE
MOUNT PROSPECT, IL 60056

WISCONSIN
HAROLD H. KOLB
S-187
LAKE GENEVA, WIS.
LAND SURVEYOR

N

SCALE: 1"=30'

LEGEND
⌀ - IRON PIPE FOUND
o - IRON PIPE PLACED
× - SPIKE
( ) - RECORDED AS

I, HAROLD H. KOLB, DO HEREBY CERTIFY THAT I HAVE SURVEYED THE PROPERTY HEREON DESCRIBED ACCORDING TO THE OFFICIAL RECORDS, AND THAT THE PLAT HEREON IS A CORRECT REPRESENTATION OF THE LOT LINES.

Harold H. Kolb
HAROLD H. KOLB
WISCONSIN REGISTERED LAND SURVEYOR, S-187
DATE May 11, 1979

117-580K