
KOLB LAND CONSULTING, INC.

LAND SURVEYING · SUBDIVIDING · LAND PLANNING

LAKE GENEVA, WISCONSIN 53147 WHITEWATER, WISCONSIN 53190

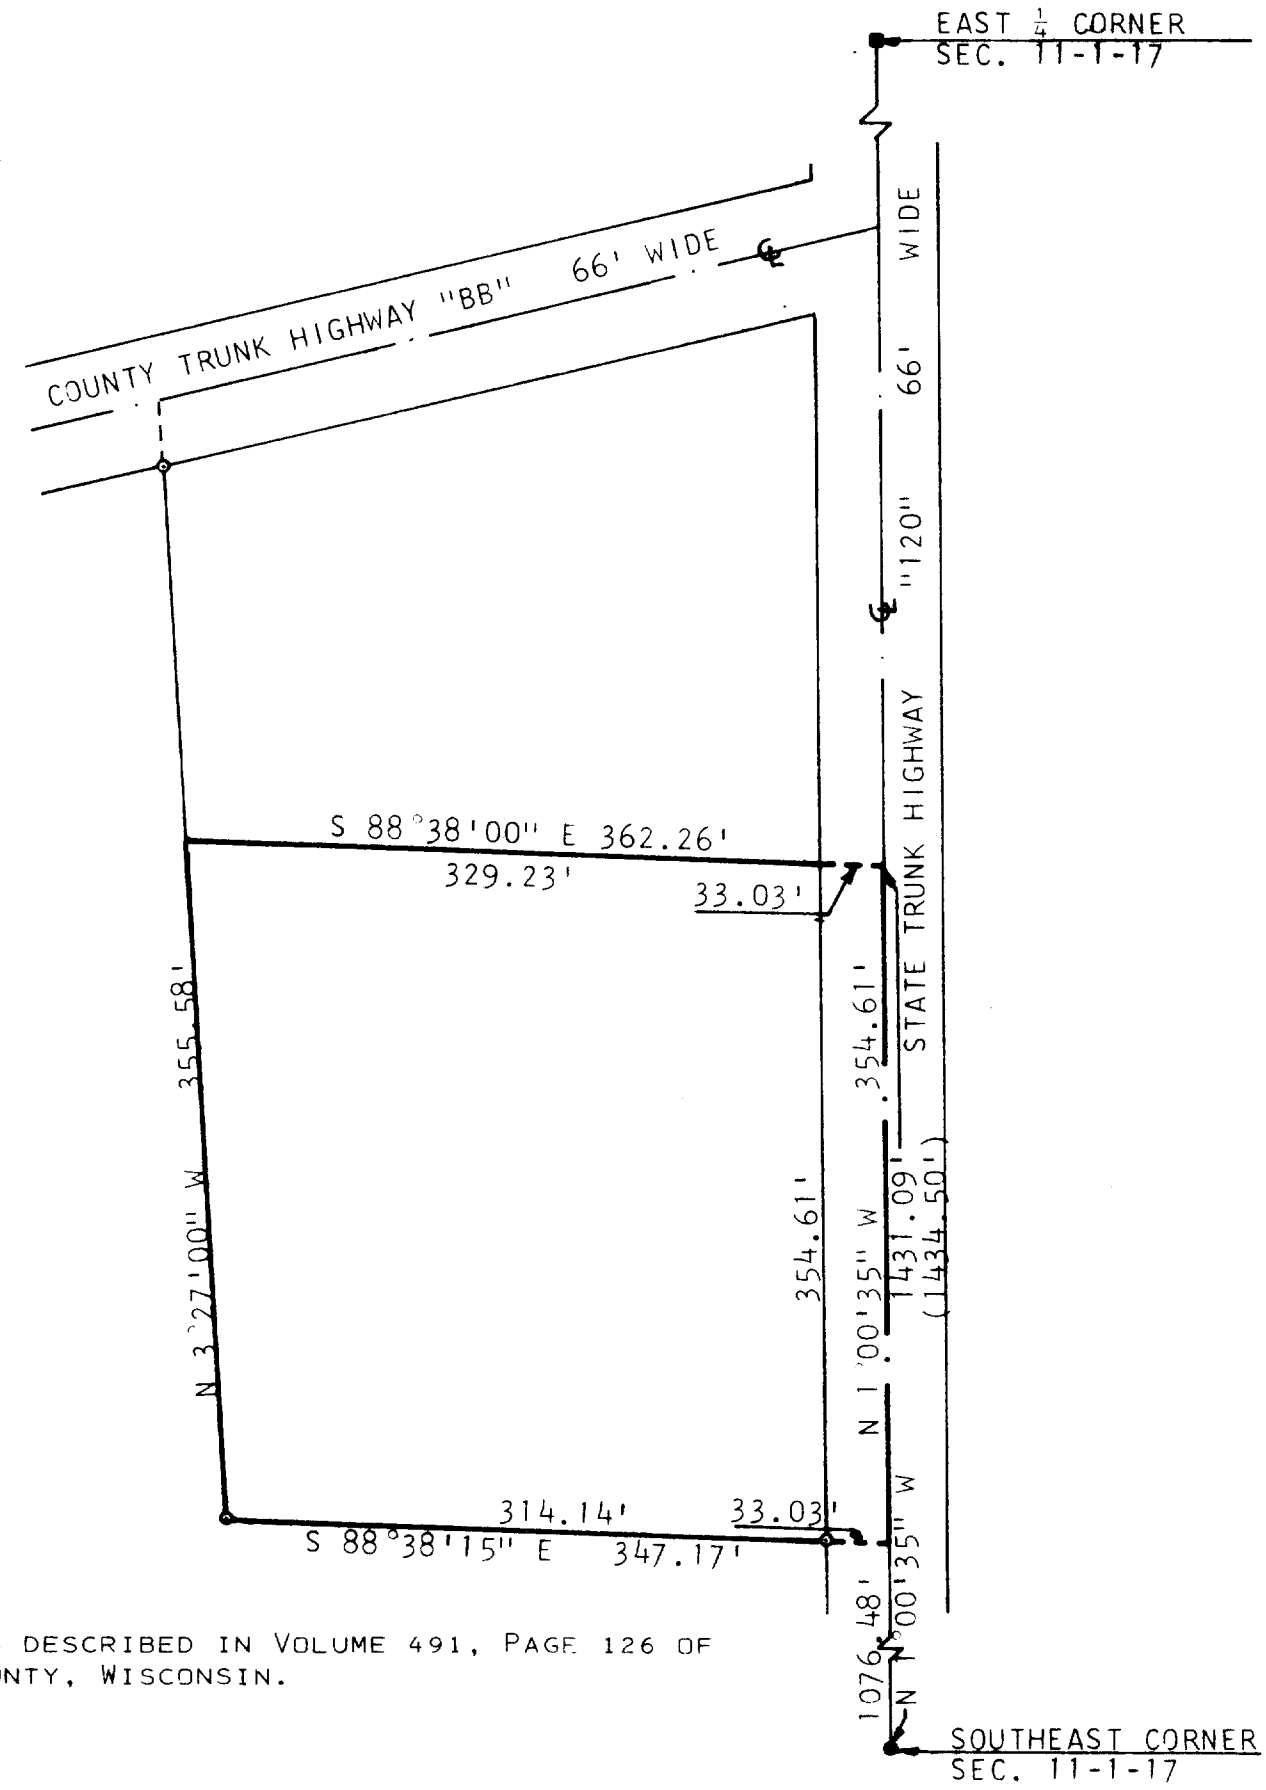

PLAT OF SURVEY OF

A PARCEL OF LAND AS DESCRIBED IN VOLUME 491, PAGE 126 OF DEEDS, WALWORTH COUNTY, WISCONSIN.

TOGETHER WITH:

A PARCEL OF LAND LOCATED IN THE SOUTHEAST 1/4 OF SECTION 11, TOWN 1 NORTH, RANGE 17 EAST, WALWORTH COUNTY, WISCONSIN, AND DESCRIBED AS FOLLOWS: COMMENCING AT THE SOUTHEAST CORNER OF SAID SECTION 11; THENCE N 1°00'35" W 1076.48 FEET TO THE PLACE OF BEGINNING; THENCE N 88°38'15" W 347.17 FEET; THENCE N 3°27'00" W 355.58 FEET; THENCE S 88°38'00" E 362.26 FEET; THENCE S 1°00'35" E 354.61 FEET TO THE PLACE OF BEGINNING. CONTAINING A GROSS AREA OF 5.22 ACRES.
NOTE: BEARINGS TIED TO WISCONSIN COORDINATE SYSTEM, SOUTH ZONE.

ORDERED BY: MRS. ELMER LEININGER
S. LAKE SHORE DRIVE
LAKE GENEVA, WI 53147

SCALE: 1"=100'

LEGEND
o -IRON PIPE SET
● -CONCRETE MONUMENT FOUND
■ -6" SQ. TOP X 9" SQ. BOTTOM X 36" CONCRETE MONUMENT FOUND
( )-RECORDED AS

WISCONSIN HAROLD H. KOLB S-187 LAKE GENEVA, WIS LAND SURVEYOR

I, HAROLD H. KOLB, DO HEREBY CERTIFY THAT I HAVE SURVEYED THE PROPERTY HEREON DESCRIBED ACCORDING TO THE OFFICIAL RECORDS, AND THAT THE PLAT HEREON IS A CORRECT REPRESENTATION OF THE LOT LINES.

Harold H. Kolb

HAROLD H. KOLB
WISCONSIN REGISTERED LAND SURVEYOR, S-187
DATE April 20, 1979

L-11-14B

117-582K