
HAROLD H. KOLB

REGISTERED PROFESSIONAL LAND SURVEYOR
LAKE GENEVA, WISCONSIN

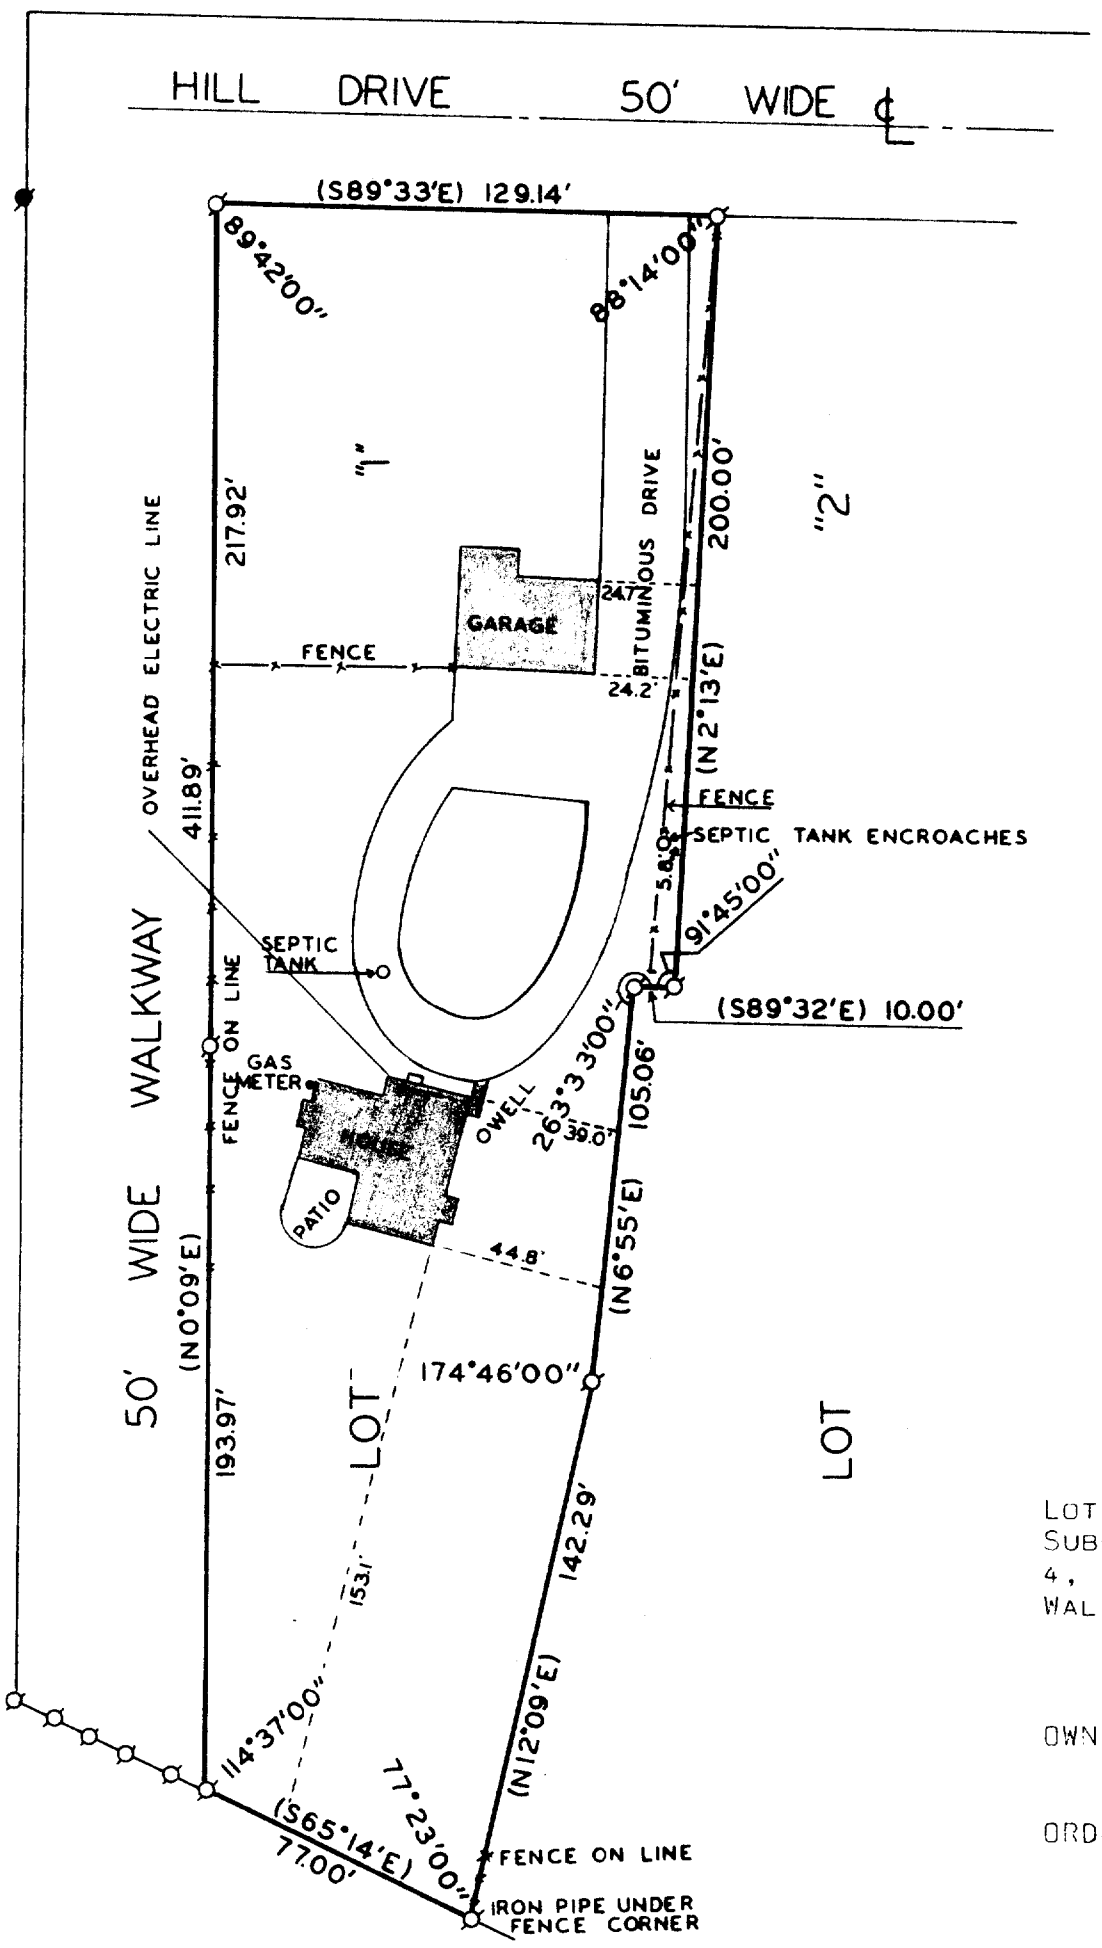

PLAT OF SURVEY OF

LOT 1, ALTA VISTA ESTATES, A SUBDIVISION LOCATED IN SECTION 4, TOWN 1 NORTH, RANGE 17 EAST, WALWORTH COUNTY, WISCONSIN.

OWNER: ROBERT METCALF

ORDERED BY: BOB KEEFE & ASSOCIATES

N

Tax Key No. IAV-1

SCALE: 1"=50'

LEGEND

- ϕ — IRON PIPE FOUND
- O — IRON PIPE PLACED
- ⌀ — CONCRETE MONUMENT FOUND
- x — SPIKE
- ( ) — AS PLATTED

I HAVE SURVEYED THE ABOVE-DESCRIBED PROPERTY AND THE ABOVE MAP IS A TRUE REPRESENTATION THEREOF AND SHOWS THE SIZE AND LOCATION OF THE PROPERTY, ITS EXTERIOR BOUNDARIES, THE LOCATION OF ALL APPARENT EASEMENTS AND ROADWAYS AND VISIBLE ENCROACHMENTS, IF ANY.

THIS SURVEY IS MADE FOR THE USE OF THE PRESENT OWNERS OF THE PROPERTY, AND ALSO THOSE WHO PURCHASE, MORTGAGE, OR GUARANTEE THE TITLE THERETO WITHIN ONE (1) YEAR FROM DATE HEREOF.

Harold H. Kolb

HAROLD H. KOLB
WISCONSIN REGISTERED LAND SURVEYOR, S-187
DATE Oct 13, 1977

117-584

BRUNING 40-108 500-6-71