
# KOLB LAND CONSULTING, INC.


LAND SURVEYING · SUBDIVIDING · LAND PLANNING

LAKE GENEVA, WISCONSIN 53147 WHITEWATER, WISCONSIN 53190

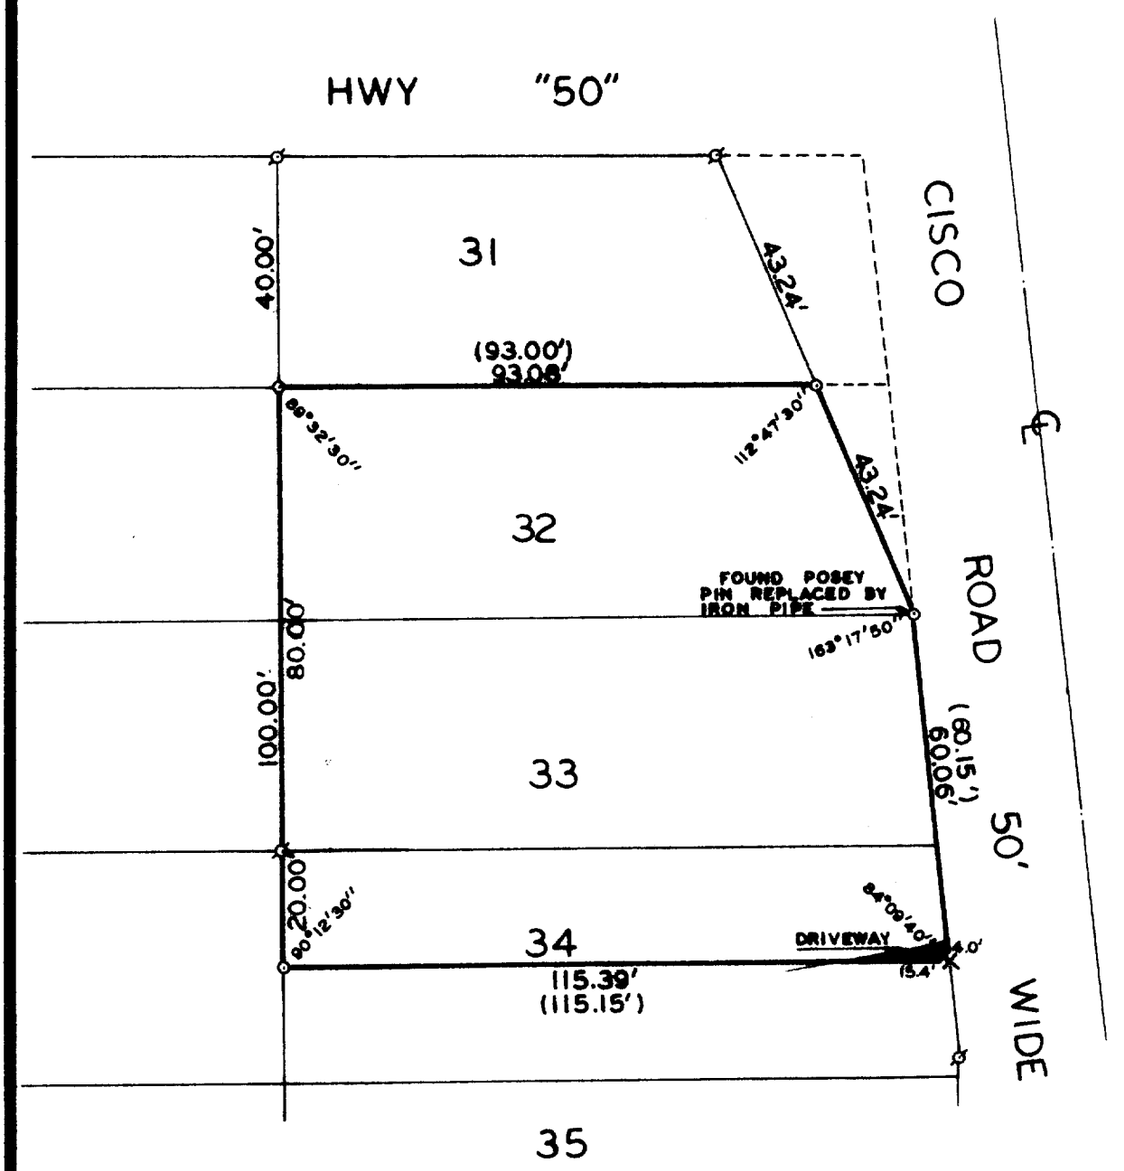


PLAT OF SURVEY OF

PART OF LOT 32, LOT 33, AND THE NORTH 20' OF LOT 34, BLOCK "J", CISCO BEACH SUBDIVISION, T1N, R17E, WALWORTH COUNTY, WISCONSIN.

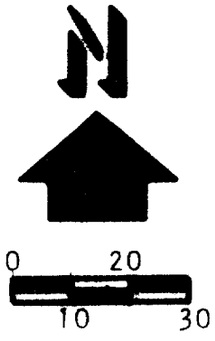


SCALE IN FEET

LEGEND:
ø-IRON PIPE FOUND
●-IRON PIPE PLACED
()-AS PLATTED




I, HAROLD H. KOLB, DO HEREBY CERTIFY THAT I HAVE SURVEYED THE PROPERTY HEREON DESCRIBED ACCORDING TO THE OFFICIAL RECORDS, AND THAT THE PLAT HEREON IS A CORRECT REPRESENTATION OF THE LOT LINES.

Harold H. Kolb

HAROLD H. KOLB
WISCONSIN REGISTERED LAND SURVEYOR, S-187
DATE June 18, 1979

ICI - 00239

117-585K