
KOLB LAND CONSULTING, INC.

LAND SURVEYING · SUBDIVIDING · LAND PLANNING

LAKE GENEVA, WISCONSIN 53147 WHITEWATER, WISCONSIN 53190

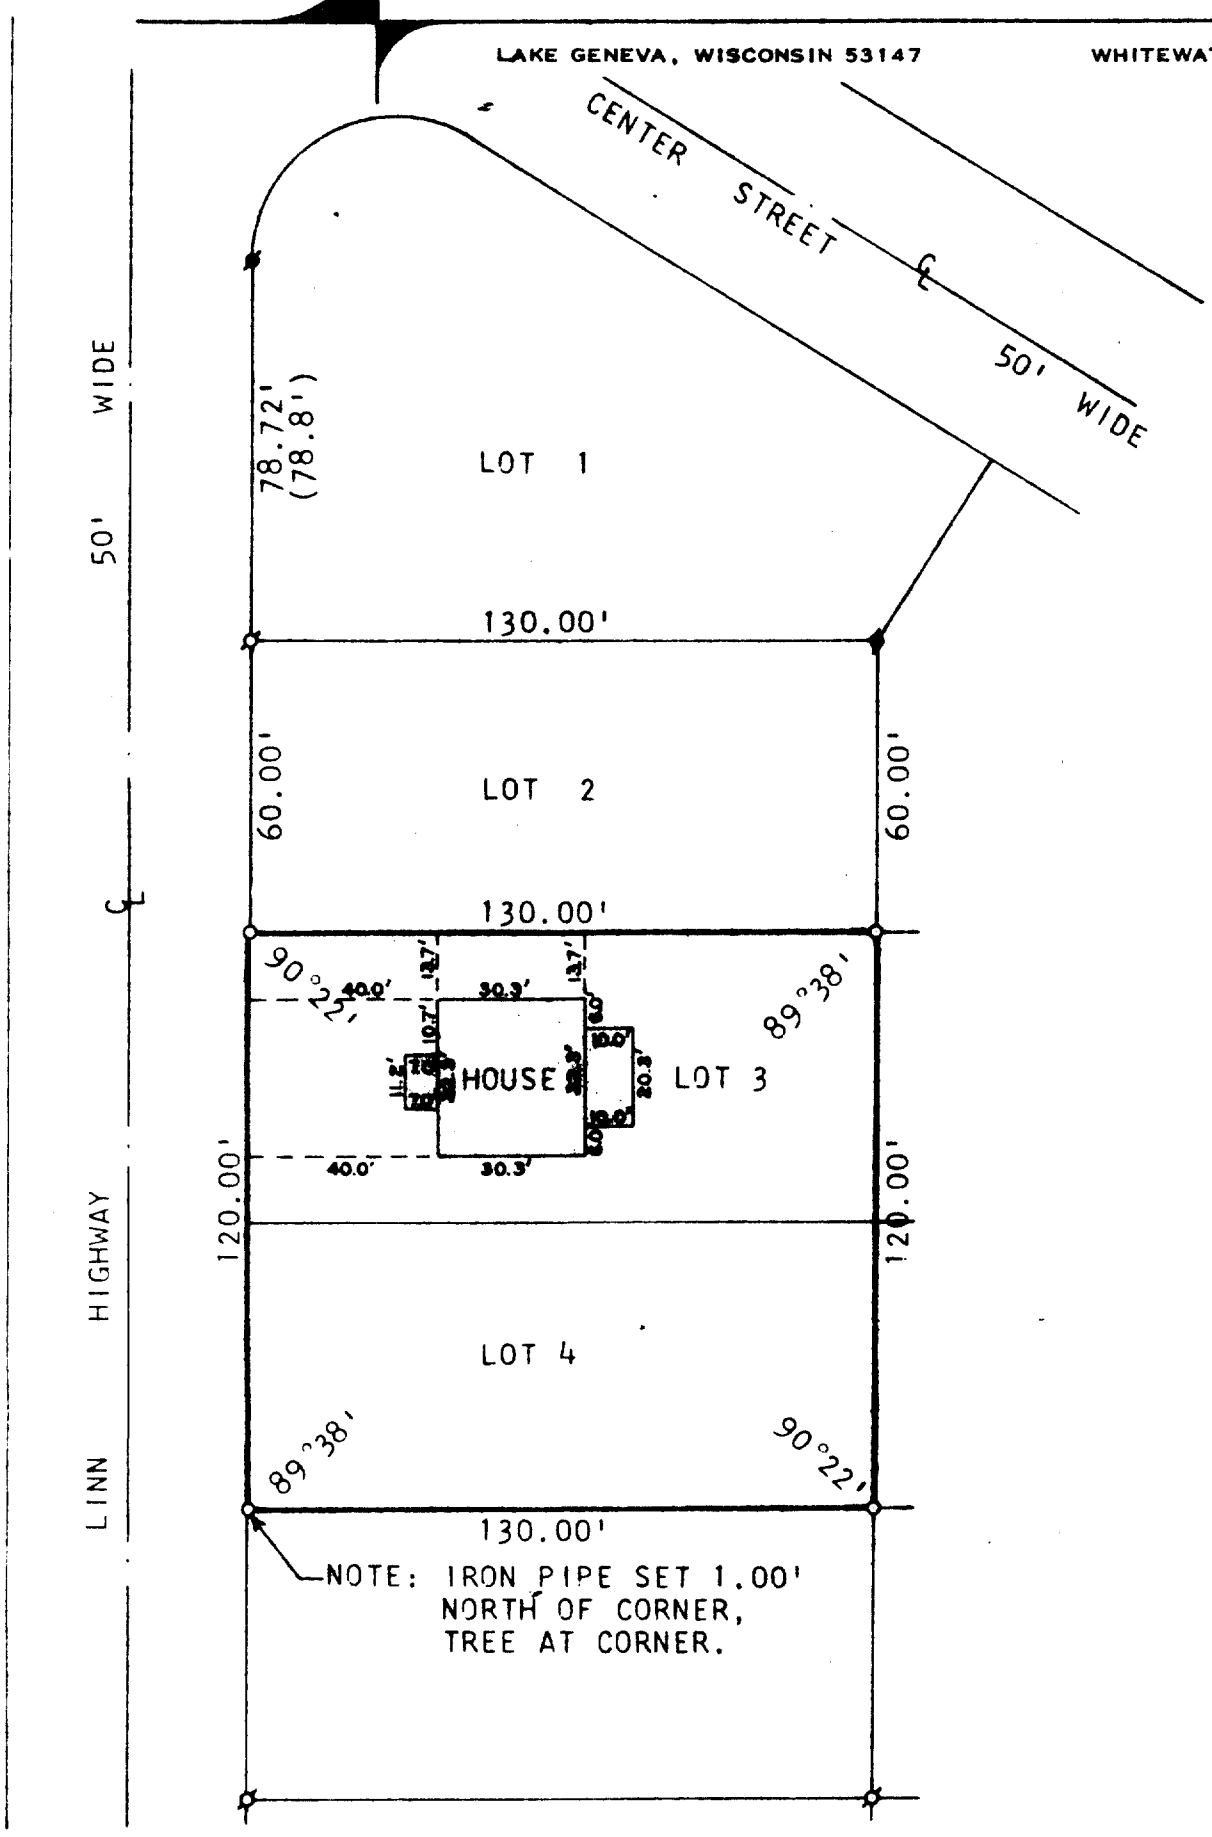

PLAT OF SURVEY OF

ORDERED BY: RICHPORT REALTOR
838 MAIN STREET
LAKE GENEVA, WI
43147

LOTS 3 AND 4, THE BIRCHES 2ND ADDITION, TOWN 1 NORTH, RANGE 17 EAST, WALWORTH COUNTY, WISCONSIN.

N

SCALE : 1" = 40'

LEGEND

- ø - IRON PIPE FOUND
- o - IRON PIPE PLACED
- ø - CONC. MONUMENT FOUND
- ( ) - AS PLATTED

WISCONSIN HAROLD H. KOLB S-187 LAKE GENEVA, WIS. LAND SURVEYOR

I, HAROLD H. KOLB, DO HEREBY CERTIFY THAT I HAVE SURVEYED THE PROPERTY HEREON DESCRIBED ACCORDING TO THE OFFICIAL RECORDS, AND THAT THE PLAT HEREON IS A CORRECT REPRESENTATION OF THE LOT LINES.

Harold H. Kolb


HAROLD H. KOLB
WISCONSIN REGISTERED LAND SURVEYOR, S-187
DATE June 12, 1979

17-587-LV

KOLB LAND CONSULTING, INC.

LAND SURVEYING · SUBDIVIDING · LAND PLANNING

LAKE GENEVA, WISCONSIN 53147 WHITEWATER, WISCONSIN 53190

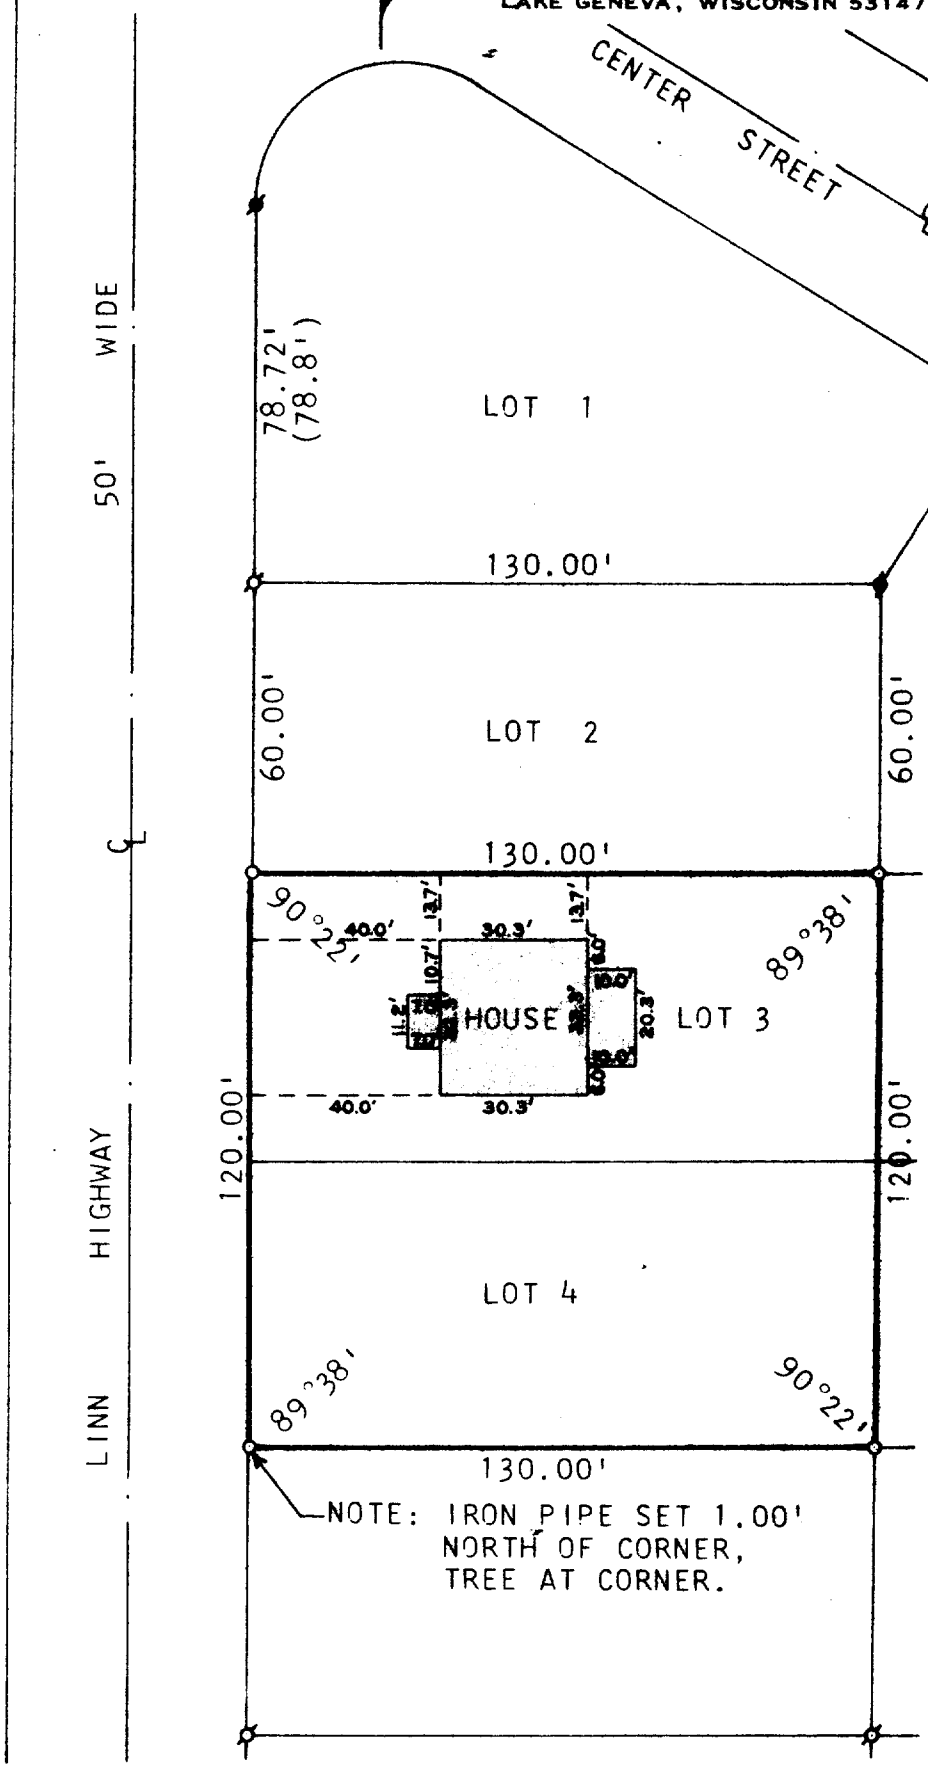

PLAT OF SURVEY OF

ORDERED BY: RICHPORT REALTOR
838 MAIN STREET
LAKE GENEVA, WI
43147

LOTS 3 AND 4, THE BIRCHES 2ND ADDITION, TOWN 1 NORTH, RANGE 17 EAST, WALWORTH COUNTY, WISCONSIN.

N

SCALE : 1" = 40'

LEGEND

ø - IRON PIPE FOUND
o - IRON PIPE PLACED
ø - CONC. MONUMENT FOUND
( ) - AS PLATTED

WISCONSIN HAROLD H. KOLB S-187 LAKE GENEVA, WIS. LAND SURVEYOR

I, HAROLD H. KOLB, DO HEREBY CERTIFY THAT I HAVE SURVEYED THE PROPERTY HEREON DESCRIBED ACCORDING TO THE OFFICIAL RECORDS, AND THAT THE PLAT HEREON IS A CORRECT REPRESENTATION OF THE LOT LINES.

Harold H. Kolb

HAROLD H. KOLB
WISCONSIN REGISTERED LAND SURVEYOR, S-187
DATE June 22, 1979

117-587K