
KOLB LAND CONSULTING, INC.

LAND SURVEYING · SUBDIVIDING · LAND PLANNING

LAKE GENEVA, WISCONSIN 53147 WHITEWATER, WISCONSIN 53190

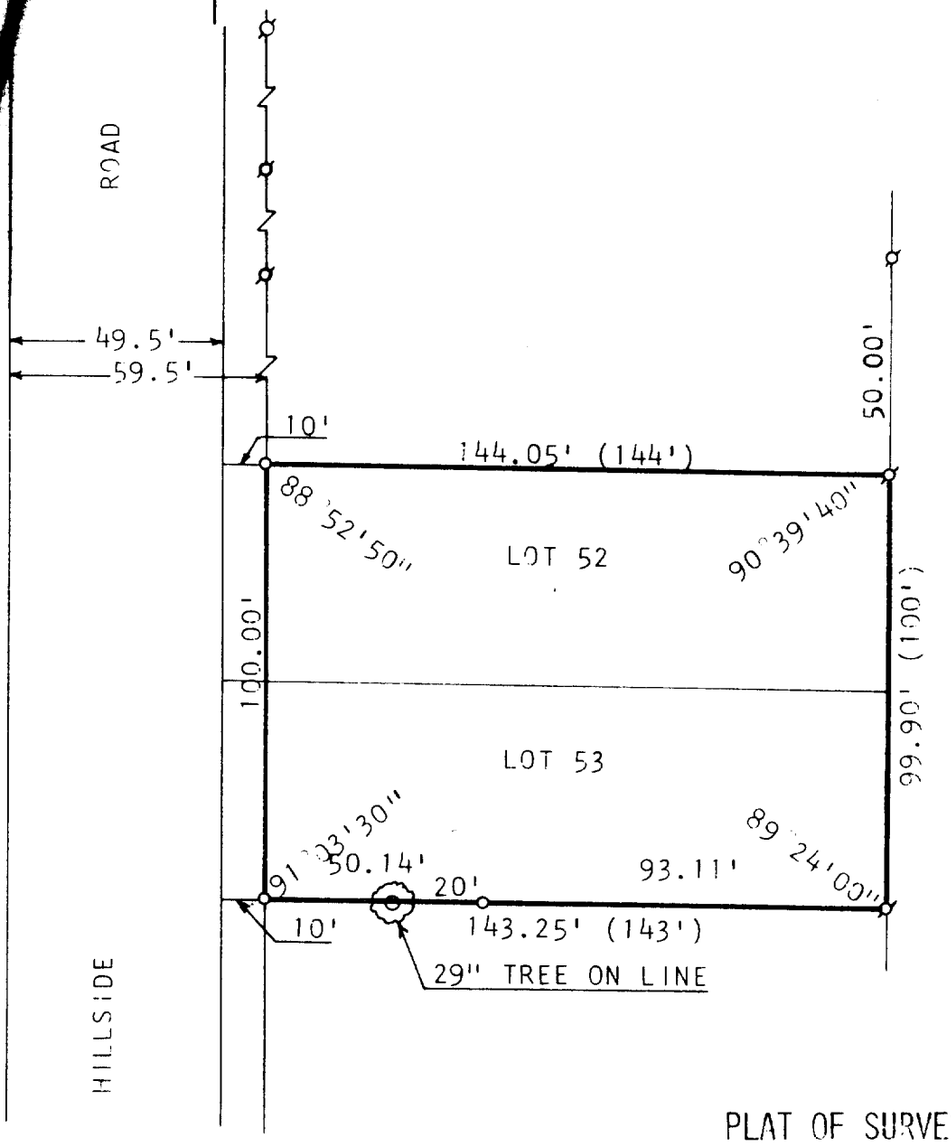

PLAT OF SURVEY OF

LOTS 52 AND 53, EXCEPT THE WESTERLY 10 FEET, LAKE GENEVA BEACH SUBDIVISION, TOWN 1 NORTH, RANGE 17 EAST, WALWORTH COUNTY, WISCONSIN.

ORDERED BY: WILLIAM M. O'MALLEY
ROUTE 1--BOX 354
LAKE GENEVA, WI 53147

WISCONSIN
HAROLD H. KOLB
S-187
LAKE GENEVA, WIS
REGISTERED LAND SURVEYOR

N

SCALE : 1"=40'

LEGEND

ø - IRON PIPE FOUND
o - IRON PIPE PLACED
() - AS PLATTED

I, HAROLD H. KOLB, DO HEREBY CERTIFY THAT I HAVE SURVEYED THE PROPERTY HEREON DESCRIBED ACCORDING TO THE OFFICIAL RECORDS, AND THAT THE PLAT HEREON IS A CORRECT REPRESENTATION OF THE LOT LINES.

Harold H. Kolb

HAROLD H. KOLB
WISCONSIN REGISTERED LAND SURVEYOR, S-187
DATE July 16, 1979

117-589 K