
HAROLD H. KOLB

REGISTERED PROFESSIONAL LAND SURVEYOR
LAKE GENEVA, WISCONSIN

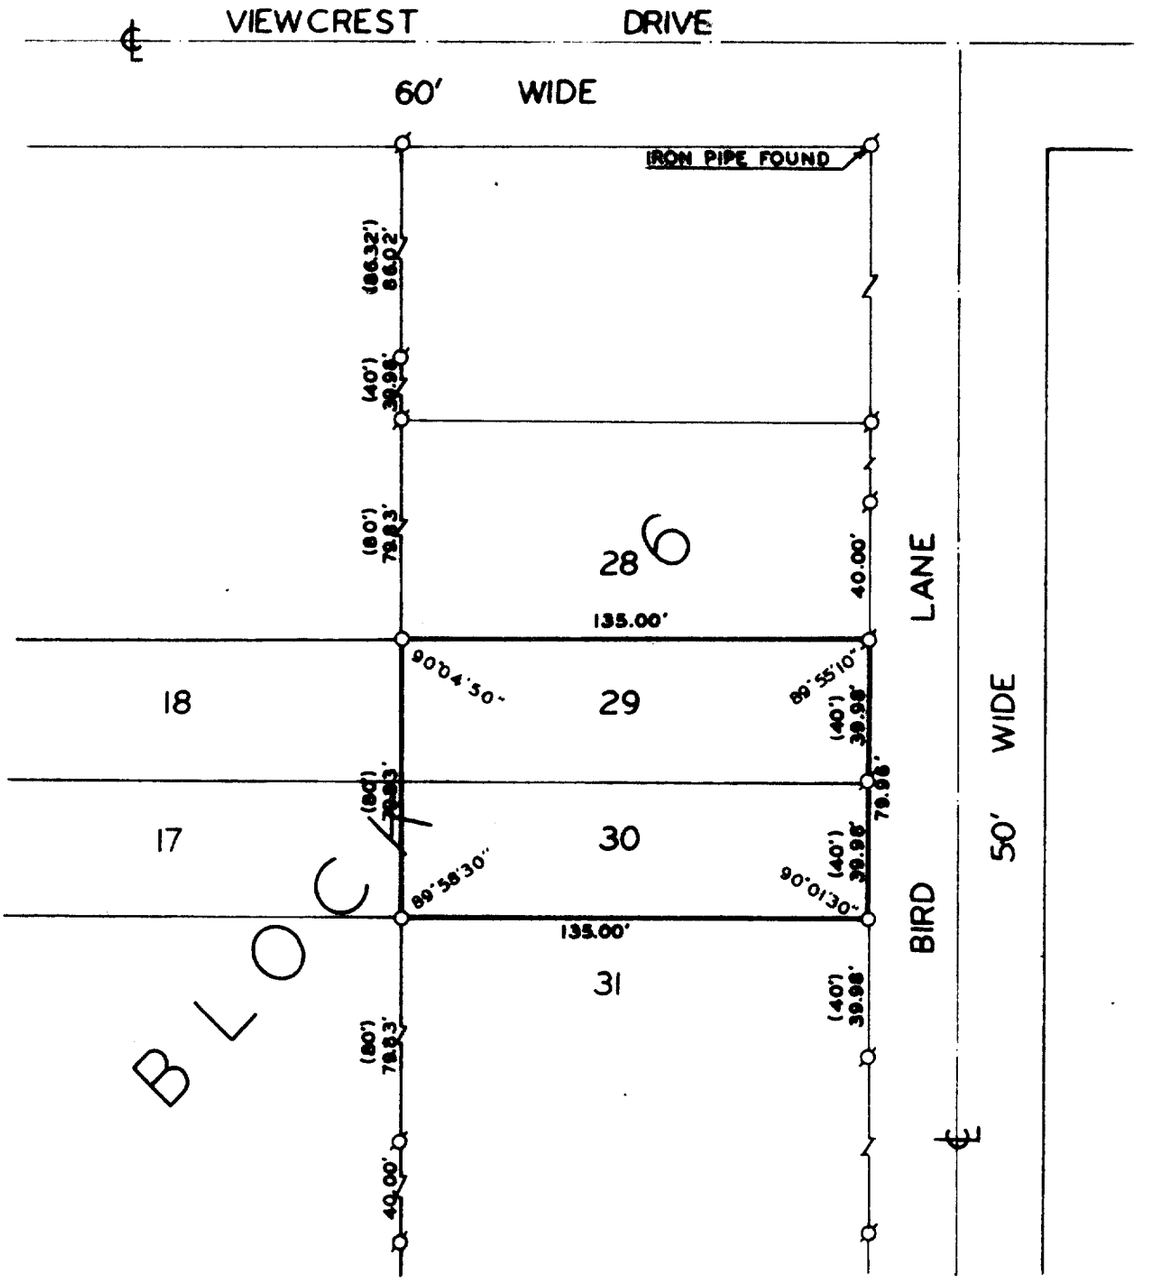

PLAT OF SURVEY OF

LOTS 29 AND 30, BLOCK 6, MAPLE HILLS SUBDIVISION,
SECTION 18, T 1 N, R 17 E, WALWORTH COUNTY, WIS.

ORDERED BY: FRANK E. WOEHRL
105 W. STRATFORD PLACE
MOUNT PROSPECT, ILL. 60056

WISCONSIN
HAROLD H. KOLB
S-187
LAND SURVEYOR

I, HAROLD H. KOLB, DO HEREBY CERTIFY THAT I HAVE SURVEYED THE PROPERTY HEREON DESCRIBED ACCORDING TO THE OFFICIAL RECORDS, AND THAT THE PLAT HEREON IS A CORRECT REPRESENTATION OF THE LOT LINES.

N

SCALE: 1"=50'

IMH-15b

LEGEND

O — IRON PIPE PLACED, 1" x 24" 1.13 LB./LIN. FT.
● — CONCRETE MONUMENT, 5" DIA. x 30"
σ - IRON ROD FOUND ()-AS PLATTED

Harold H. Kolb
HAROLD H. KOLB
WISCONSIN REGISTERED LAND SURVEYOR, S-187
DATE July 12, 1978

BRUNING 40-105 1M-6-71

117-608