
KOLB LAND CONSULTING, INC.

LAND SURVEYING · SUBDIVIDING · LAND PLANNING

LAKE GENEVA, WISCONSIN 53147 WHITEWATER, WISCONSIN 53190

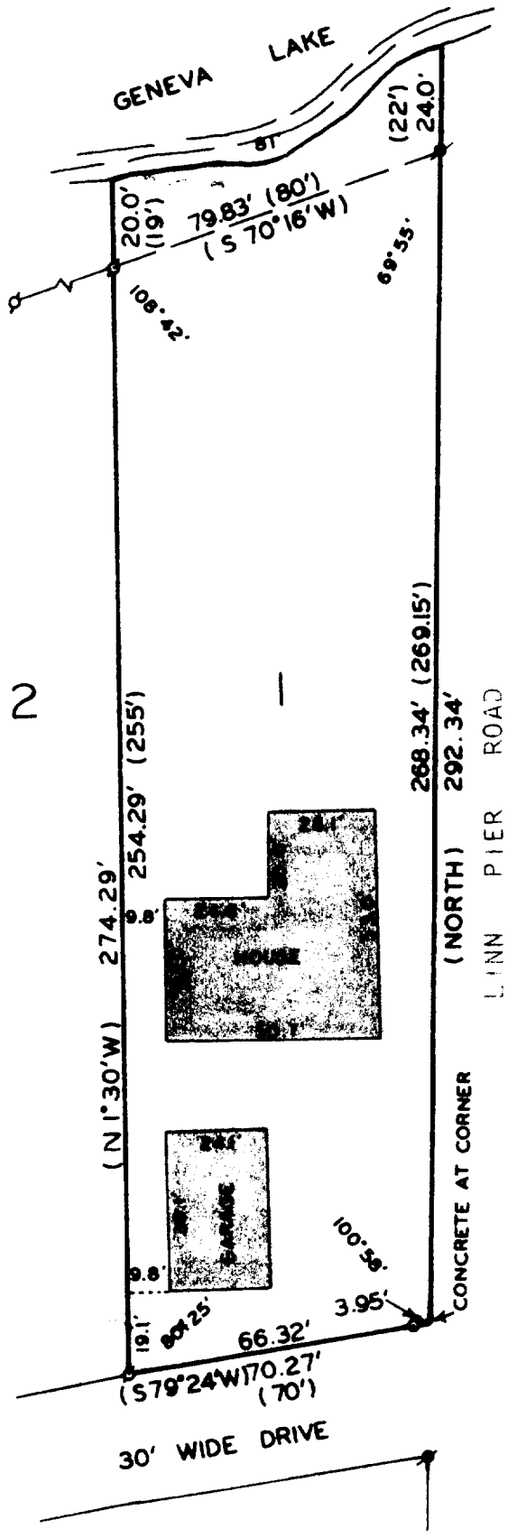

PLAT OF SURVEY OF

LOT 1, THE BIRCHES 1ST ADDITION,
TOWN 1 NORTH, RANGE 17 EAST,
WALWORTH COUNTY, WISCONSIN.

ORDERED BY: JOSEPH INGOLIA
18 N. EAST AVENUE
PARK RIDGE, IL 60068

SCALE · 1"=40'

o– IRON PIPE SET
ø – IRON PIPE FOUND
● – IRON PIPE IN CONCRETE FOUND
( ) – AS PLATTED

WISCONSIN HAROLD H. KOLB S-187 REGISTERED LAND SURVEYOR

I, HAROLD H. KOLB, DO HEREBY CERTIFY THAT I HAVE SURVEYED THE PROPERTY HEREON DESCRIBED ACCORDING TO THE OFFICIAL RECORDS, AND THAT THE PLAT HEREON IS A CORRECT REPRESENTATION OF THE LOT LINES TO THE BEST OF MY KNOWLEDGE AND BELIEF.

Harold H. Kolb

HAROLD H. KOLB
WISCONSIN REGISTERED LAND SURVEYOR, S-187

DATE Nov. 20, 1979

I-BA 1-1

117-623K