
FARRIS, HANSEN & COOPER, INC.
ENGINEERING, SURVEYING AND LAND PLANNING
715 W. WALWORTH ST. - P.O. BOX 487 - ELKHORN, WI 53121

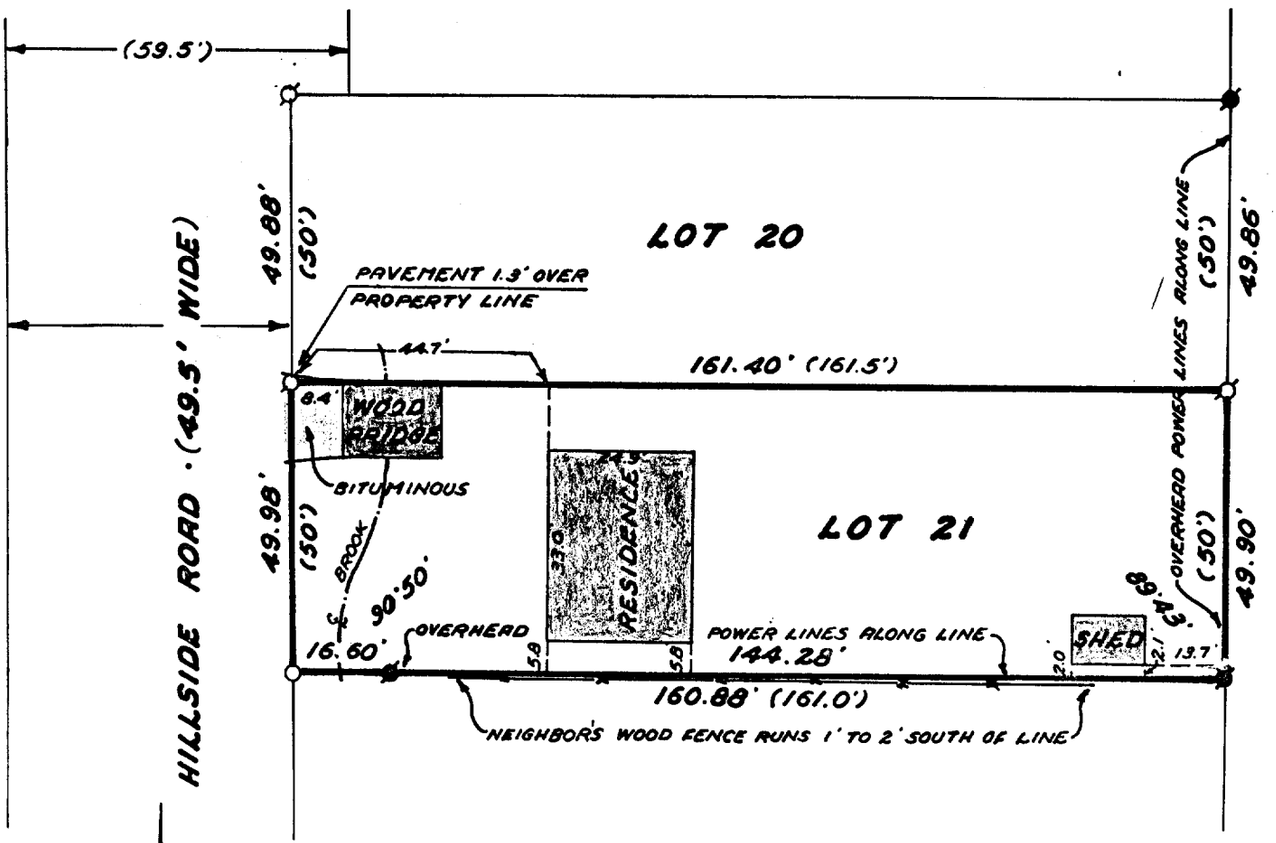

PLAT OF SURVEY OF

Lot 21 of Lake Geneva Beach subdivision, Section 11, Town 1 North, Range 17 East, Town of Linn, Walworth County, Wisconsin.

ORDERED BY: Keefe Real Estate
% Emily DeBaere

0 10 20 30
SCALE IN FEET
1"=30'

LEGEND

- —Iron Pipe Found
- —Concrete Monument Found
- —1" Dia. Iron Pipe Set
- ()—Record Dimension

WISCONSIN
DANIEL D. COOPER
S-1464
EAST TROY, WIS.
LAND SURVEYOR

I HEREBY CERTIFY that I have surveyed the property described hereon and that this Plat of Survey is a true and accurate representation of the lot lines and the buildings located thereon to the best of my professional knowledge and belief.

Daniel D. Cooper
Daniel D. Cooper, RLS No. 1464
Dated this 13 day of Sept. 1979.

PROJ. NO. 1593

117-634