FARRIS, HANSEN & COOPER, INC.
ENGINEERING, SURVEYING AND LAND PLANNING
715 W. WALWORTH ST. - P.O. BOX 487 - ELKHORN, WI 53121
OFFICE: 414/723-2098

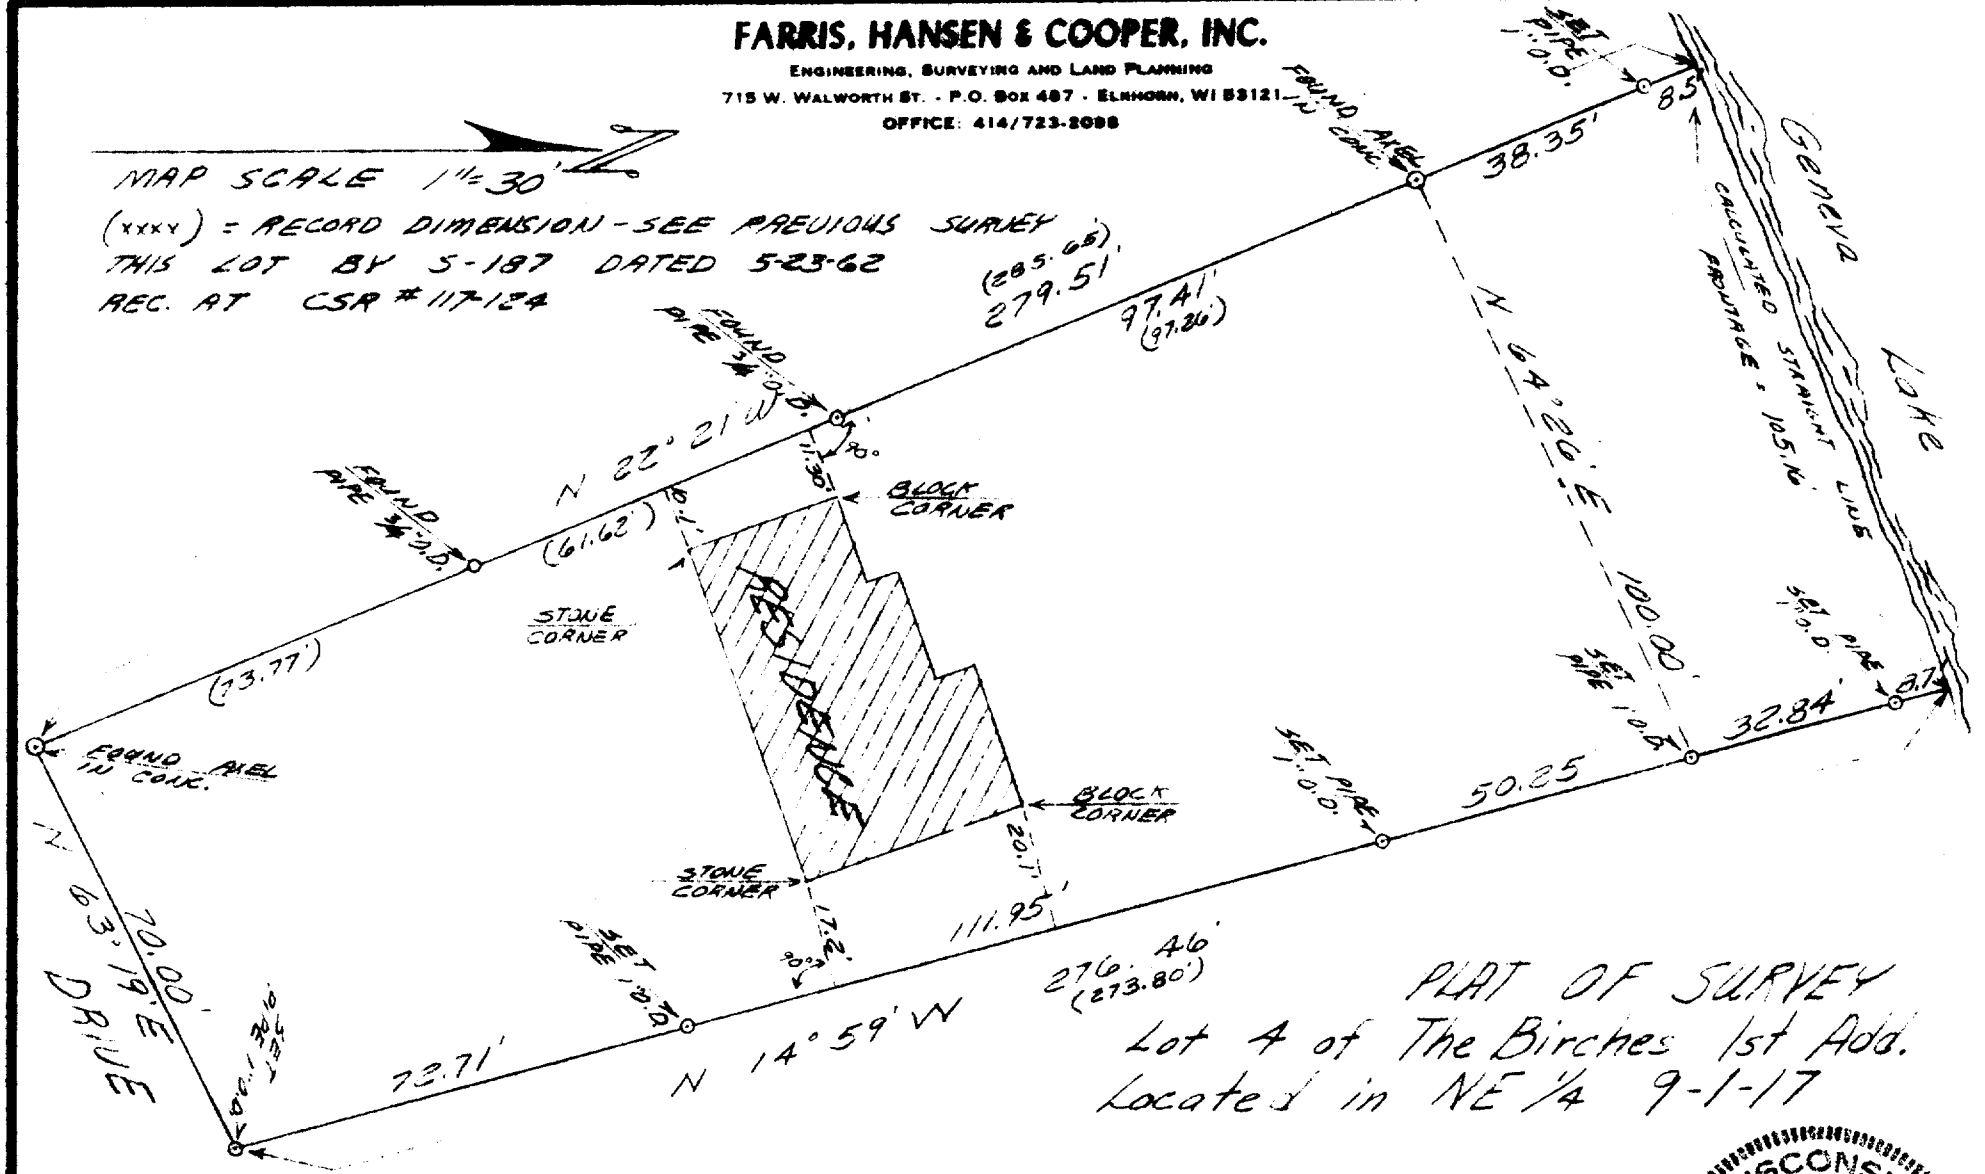

PLAT OF SURVEY
Lot 4 of The Birches 1st Add.
Located in NE ¼ 9-1-17

I HEREBY CERTIFY THAT, AT THE DIRECTION OF HARRY HOSTETLER, I HAVE SURVEYED THE PROPERTY DESCRIBED HEREON AND THAT THIS PLAT OF SURVEY IS A TRUE AND ACCURATE REPRESENTATION OF THE LOT LINES AND OF THE BUILDING CORNERS TO THE BEST OF MY PROFESSIONAL KNOWLEDGE AND BELIEF

WISCONSIN ROBERT A. FARRIS S-1360 ELKHORN WIS. REGISTERED LAND SURVEYOR

Robert A. Farris

15 JUNE 1962

DRAWING NUMBER 1968

117-651-F