
[redacted]

WISCONSIN
ROBERT A. FARRIS
S-1293
ELKHORN, WIS
LAND SURVEYOR

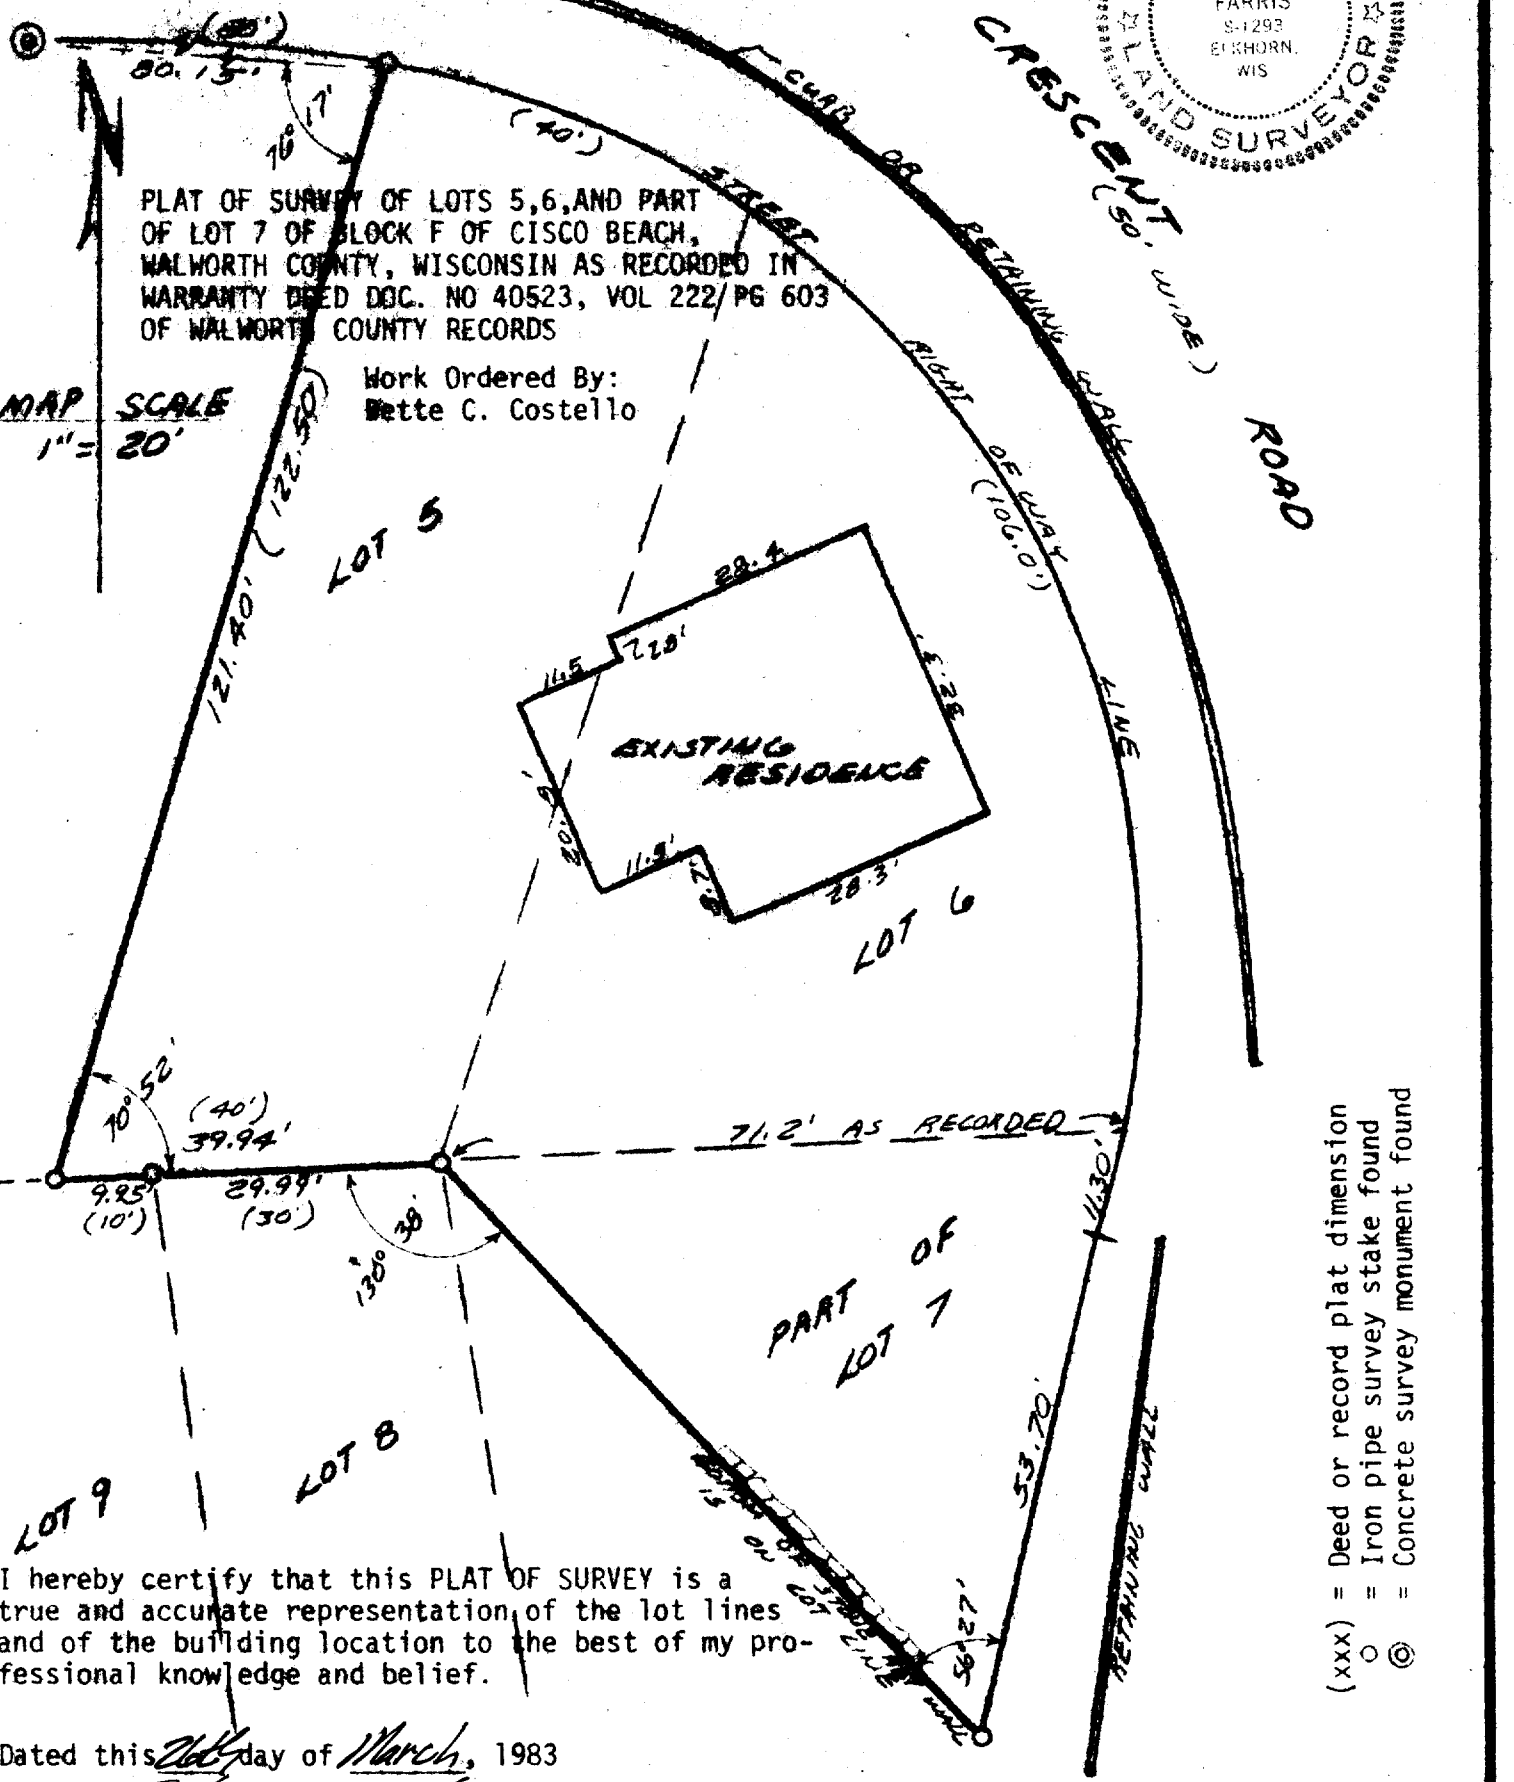

(xxx) = Deed or record plat dimension
○ = Iron pipe survey stake found
◎ = Concrete survey monument found

I hereby certify that this PLAT OF SURVEY is a true and accurate representation of the lot lines and of the building location to the best of my professional knowledge and belief.

Dated this 26th day of March, 1983

Robert A. Farris

DRAWING NUMBER 2065

FCI-00109

17-656-F