
KOLB LAND CONSULTING, INC.

LAND SURVEYING · SUBDIVIDING · LAND PLANNING

LAKE GENEVA, WISCONSIN 53147

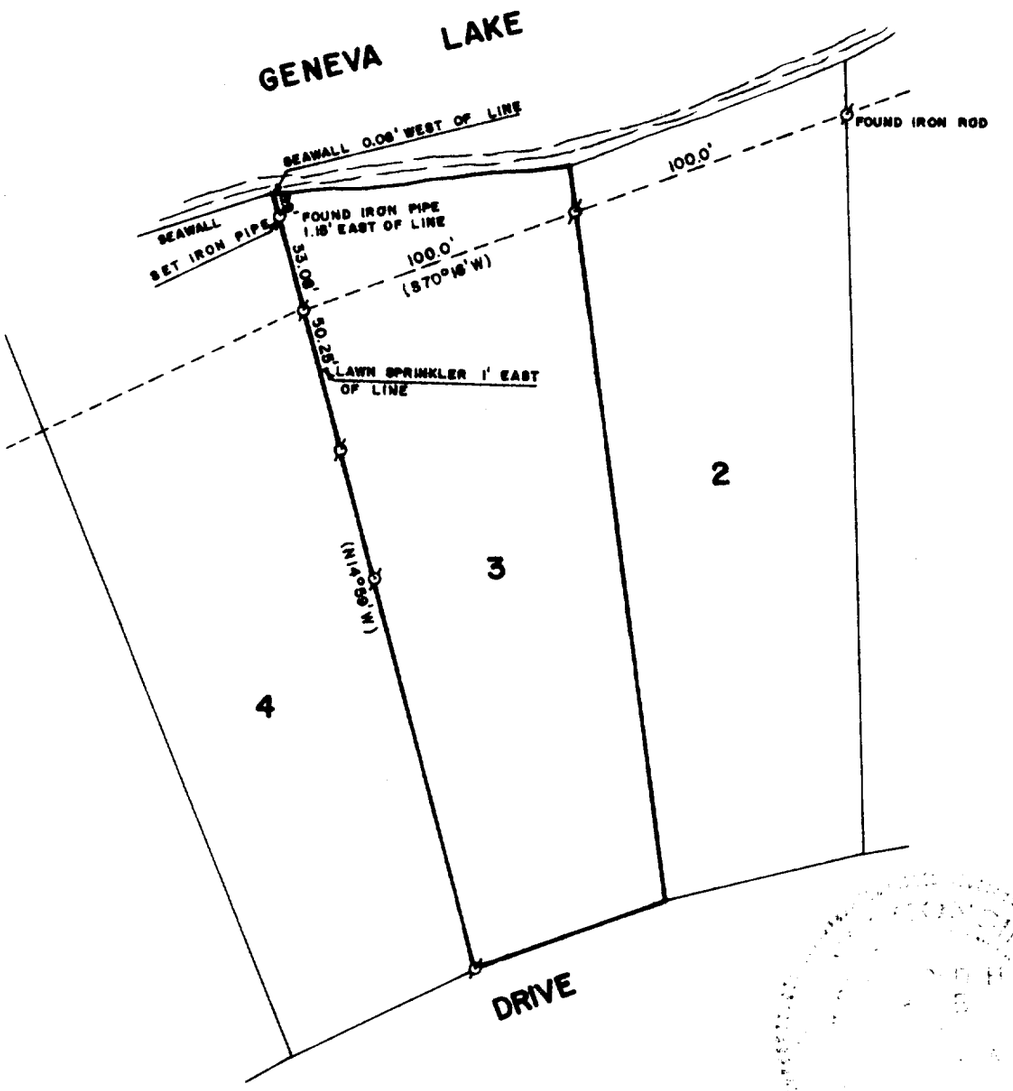

PLAT OF SURVEY OF

LOT 3, THE BIRCHES 1ST ADDITION, A SUBDIVISION LOCATED IN T 1 N, R 17 E, WALWORTH COUNTY, WI.

ORDERED BY: MILES MATOUSEK
RT. 1, BOX 1288
LAKE GENEVA, WI 53147

SCALE: 1"=60'

ø - IRON PIPE FOUND OR
o AS NOTED
( ) AS RECORDED

I, HAROLD H. KOLB, DO HEREBY CERTIFY THAT I HAVE SURVEYED THE PROPERTY HEREON DESCRIBED ACCORDING TO THE OFFICIAL RECORDS, AND THAT THE PLAT HEREON IS A CORRECT REPRESENTATION OF THE LOT LINES TO THE BEST OF MY KNOWLEDGE AND BELIEF.

Harold H. Kolb

WISCONSIN REGISTERED LAND SURVEYOR, S- 187

DATE Sept. 27, 1983

117- 656-K