
WALWORTH COUNTY
SURVEYING & MAPPING
LAKE GENEVA, WISCONSIN

RECEIVED
JUL 30 1985

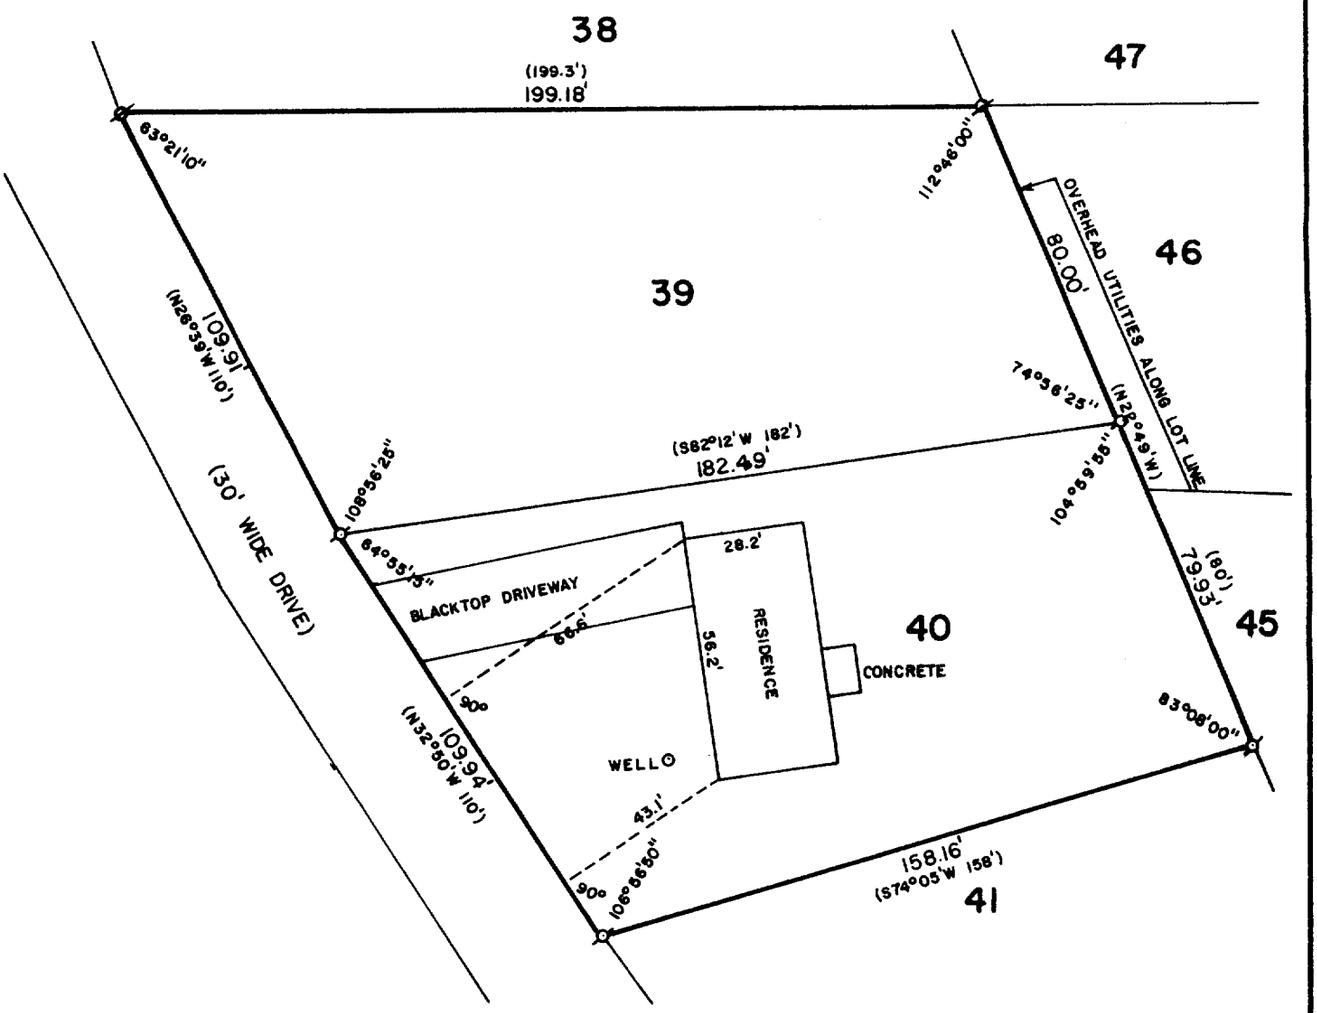

PLAT OF SURVEY OF

LOTS 39 AND 40 OF THE BIRCHES FIRST ADDITION, LOCATED IN SECTION 9, T 1 N, R 17 E, WALWORTH COUNTY, WISCONSIN.

ORDERED BY: SONTAG REALTY, INC.
RT. 1, P. O. BOX 360
LAKE GENEVA, WISCONSIN 53147

WISCONSIN
ROBERT M.
BAERENWALD
Lake Geneva, WI.
S-1508
LAND SURVEYOR

SCALE: 1"=40'

ø -IRON PIPE FOUND
ø -AXEL ROD FOUND
() -RECORDED AS

I, ROBERT M. BAERENWALD, DO HEREBY CERTIFY THAT I HAVE SURVEYED THE PROPERTY HEREON DESCRIBED ACCORDING TO THE OFFICIAL RECORDS AND THAT THE PLAT HEREON IS A CORRECT REPRESENTATION OF THE PROPERTY LINES TO THE BEST OF MY KNOWLEDGE AND BELIEF.

Robert M. Baerenwald
ROBERT M. BAERENWALD
WISCONSIN REGISTERED LAND SURVEYOR, S-1508

June 7, 1984
DATE

JOB NO. 0065

117-666-B