
KOLB LAND CONSULTING, INC.

LAND SURVEYING · SUBDIVIDING · LAND PLANNING

LAKE GENEVA, WISCONSIN 53147 WHITEWATER, WISCONSIN 53190

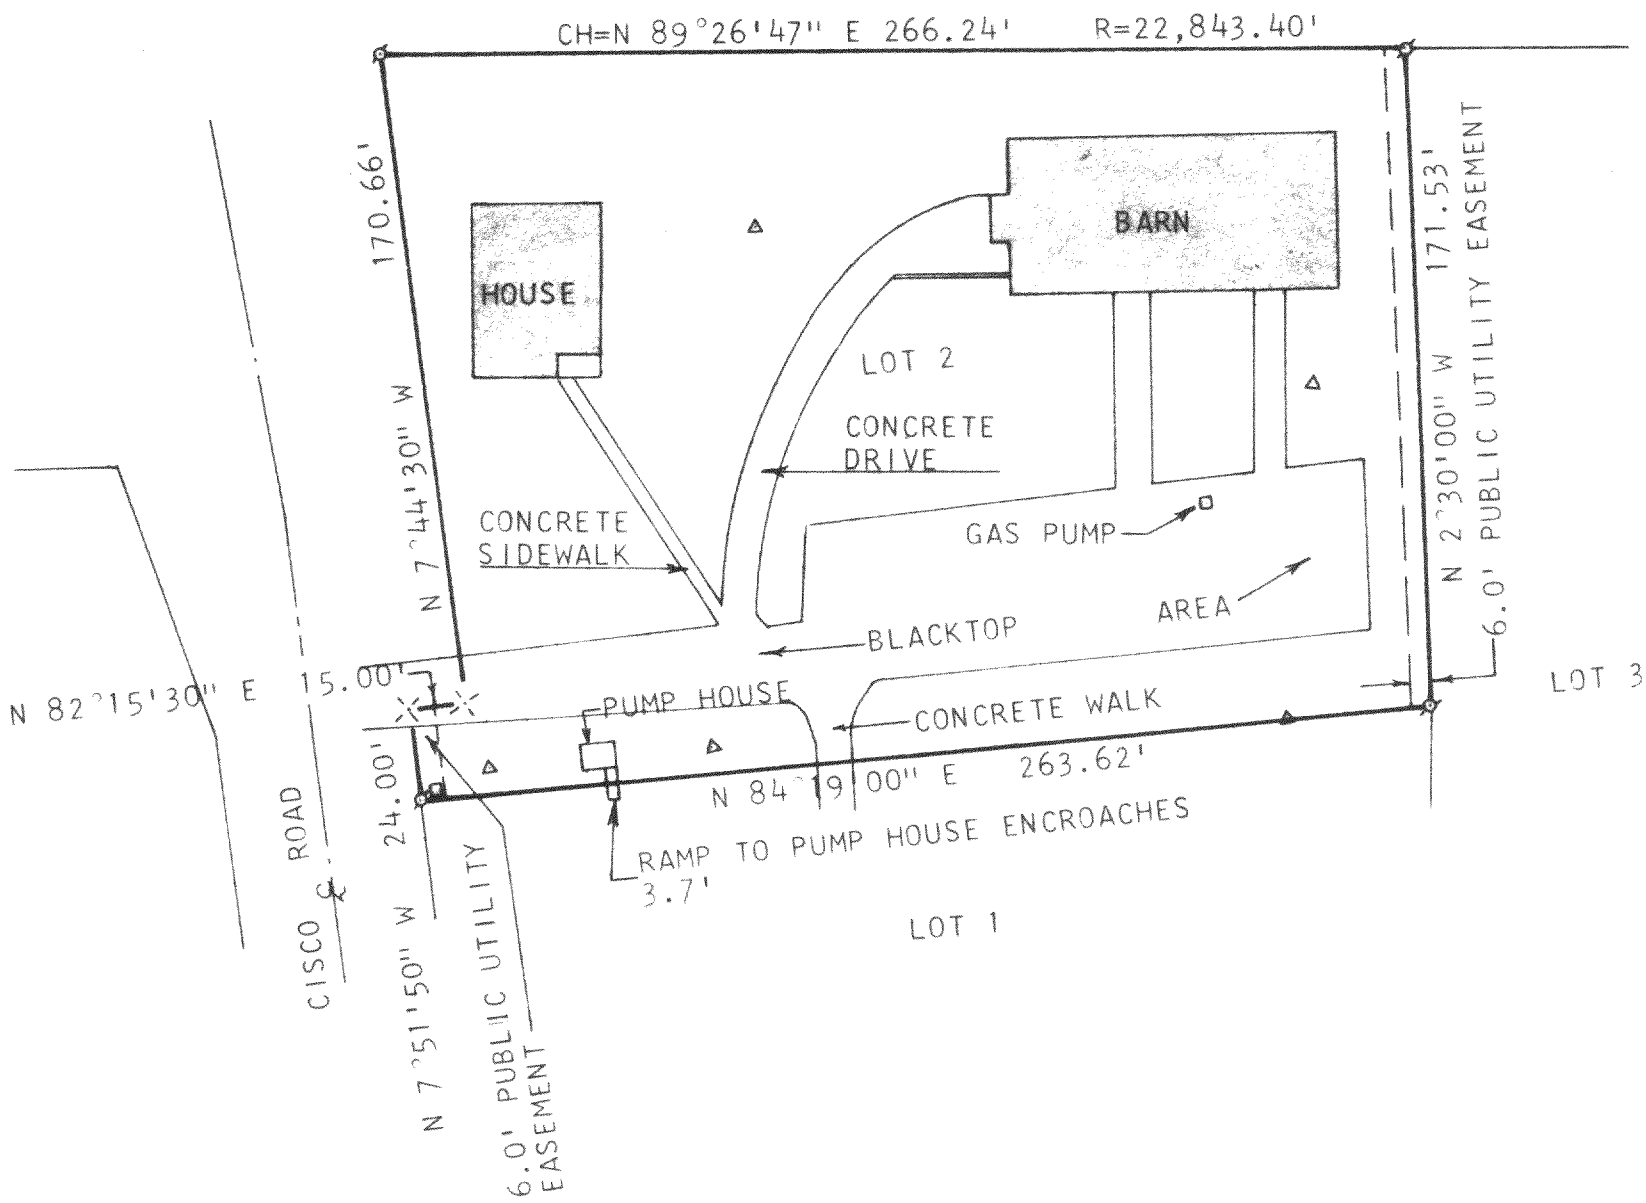

PLAT OF SURVEY OF

LOT 2 OF ARA GLEN ESTATES, TOWN 1 NORTH, RANGE 17 EAST, WALWORTH COUNTY, WISCONSIN.

ORDERED BY: BRADEN & OLSEN
716 WISCONSIN ST.
LAKE GENEVA, WI 53147

NOTE: BEARINGS ARE AS SHOWN ON THE SUBDIVISION PLAT OF ARA GLEN ESTATES.

SCALE - 1"=50'

LEGEND
- ⌀ - IRON PIPE FOUND
- ✕ - RAILROAD SPIKE FOUND
- ▫ - TELEPHONE PED.
- △ - MANHOLE

WISCONSIN HAROLD H. KOLB S-187 LAKE GENEVA WIS LAND SURVEYOR

I, HAROLD H. KOLB, DO HEREBY CERTIFY THAT I HAVE SURVEYED THE PROEPRTY HEREON DESCRIBED ACCORDING TO THE OFFICIAL RECORDS, AND THAT THE PLAT HEREON IS A CORRECT REPRESENTATION OF THE LOT LINES AND THE PRINCIPAL LINES OF THE IMPROVEMENTS THEREON TO THE BEST OF MY KNOWLEDGE AND BELIEF.

Harold H. Kolb

WISCONSIN REGISTERED LAND SURVEYOR, S-187

DATE AUGUST 11, 1983

117-666-K