
RECEIVED
JUL 1985

WALWORTH COUNTY
SURVEYING & MAPPING
LAKE GENEVA, WISCONSIN

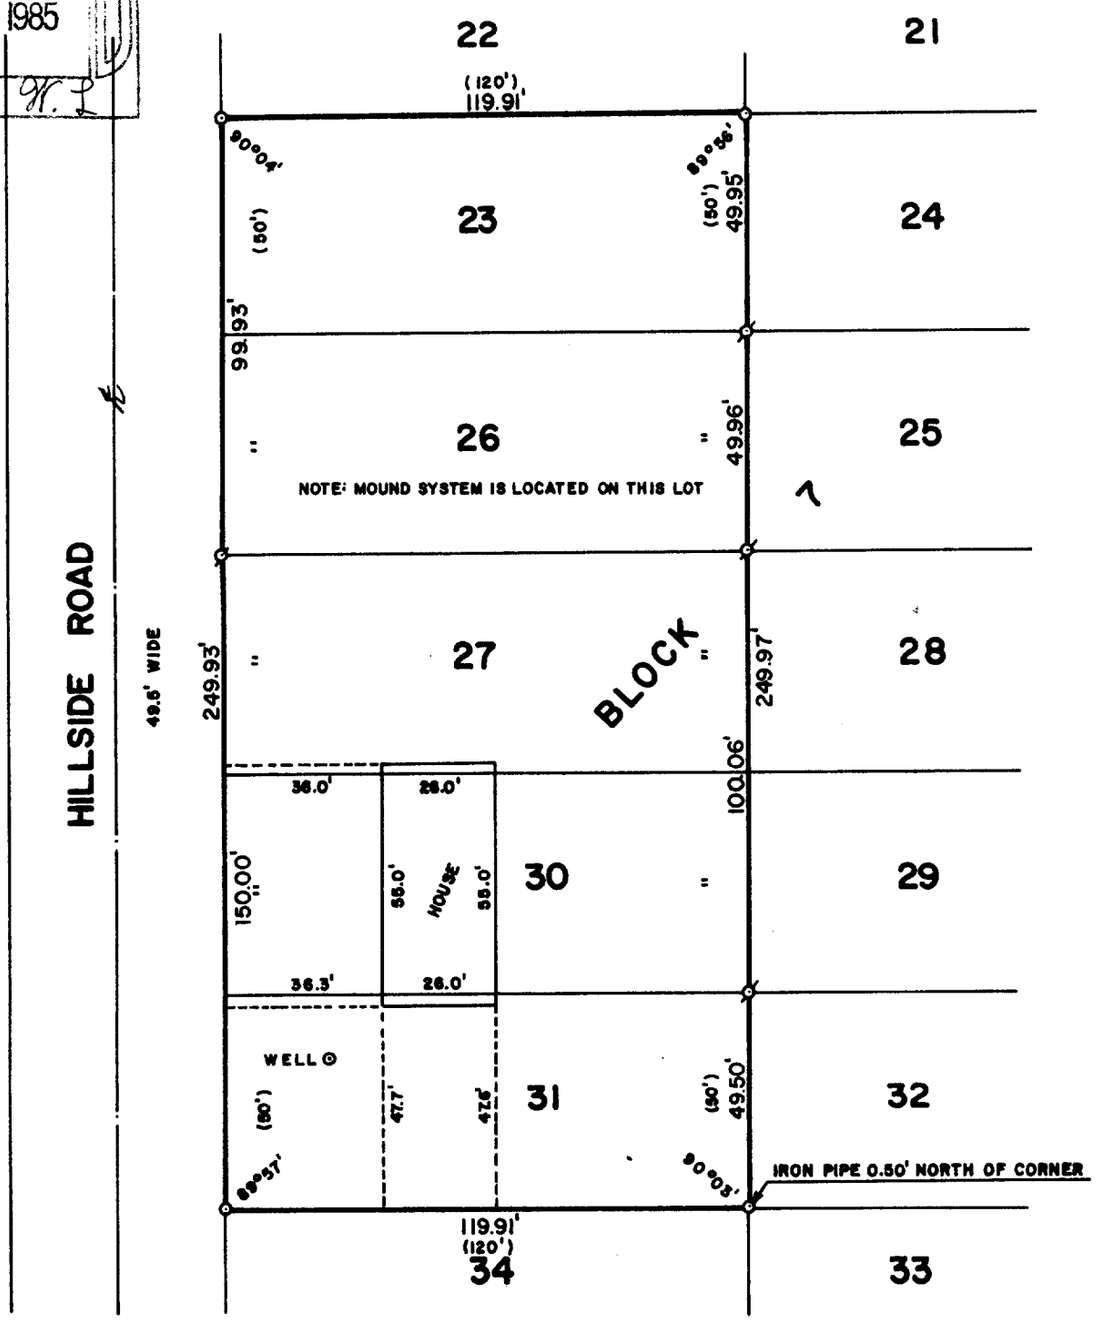

WISCONSIN
ROBERT M. BAERENWALD
Lake Geneva, WI.
S-1508
LAND SURVEYOR

PLAT OF SURVEY OF

LOTS 23, 26, 27, 30 AND 31, BLOCK 7 OF ROBINSON HILLSIDE SUBDIVISION, T 1 N, R 17 E, WALWORTH COUNTY, WISCONSIN.

ORDERED BY: CITIZENS NATIONAL BANK
401 BROAD STREET
LAKE GENEVA, WISCONSIN

SCALE: 1"=40'

ø -IRON PIPE FOUND
o -IRON PIPE PLACED
() -RECORDED AS

I, ROBERT M. BAERENWALD, DO HEREBY CERTIFY THAT I HAVE SURVEYED THE PROPERTY HEREON DESCRIBED ACCORDING TO THE OFFICIAL RECORDS AND THAT THE PLAT HEREON IS A CORRECT REPRESENTATION OF THE PROPERTY LINES TO THE BEST OF MY KNOWLEDGE AND BELIEF.

Robert M. Baerenwald
ROBERT M. BAERENWALD
WISCONSIN REGISTERED LAND SURVEYOR, S-1508

Nov. 19, 1984
DATE JOB NO. 0158

117-673-B