
DUNHAM SURVEYING, S. C.
SURVEYING & SUBDIVIDING
DELAVAN, WISCONSIN 53115

RECEIVED
MAY 5

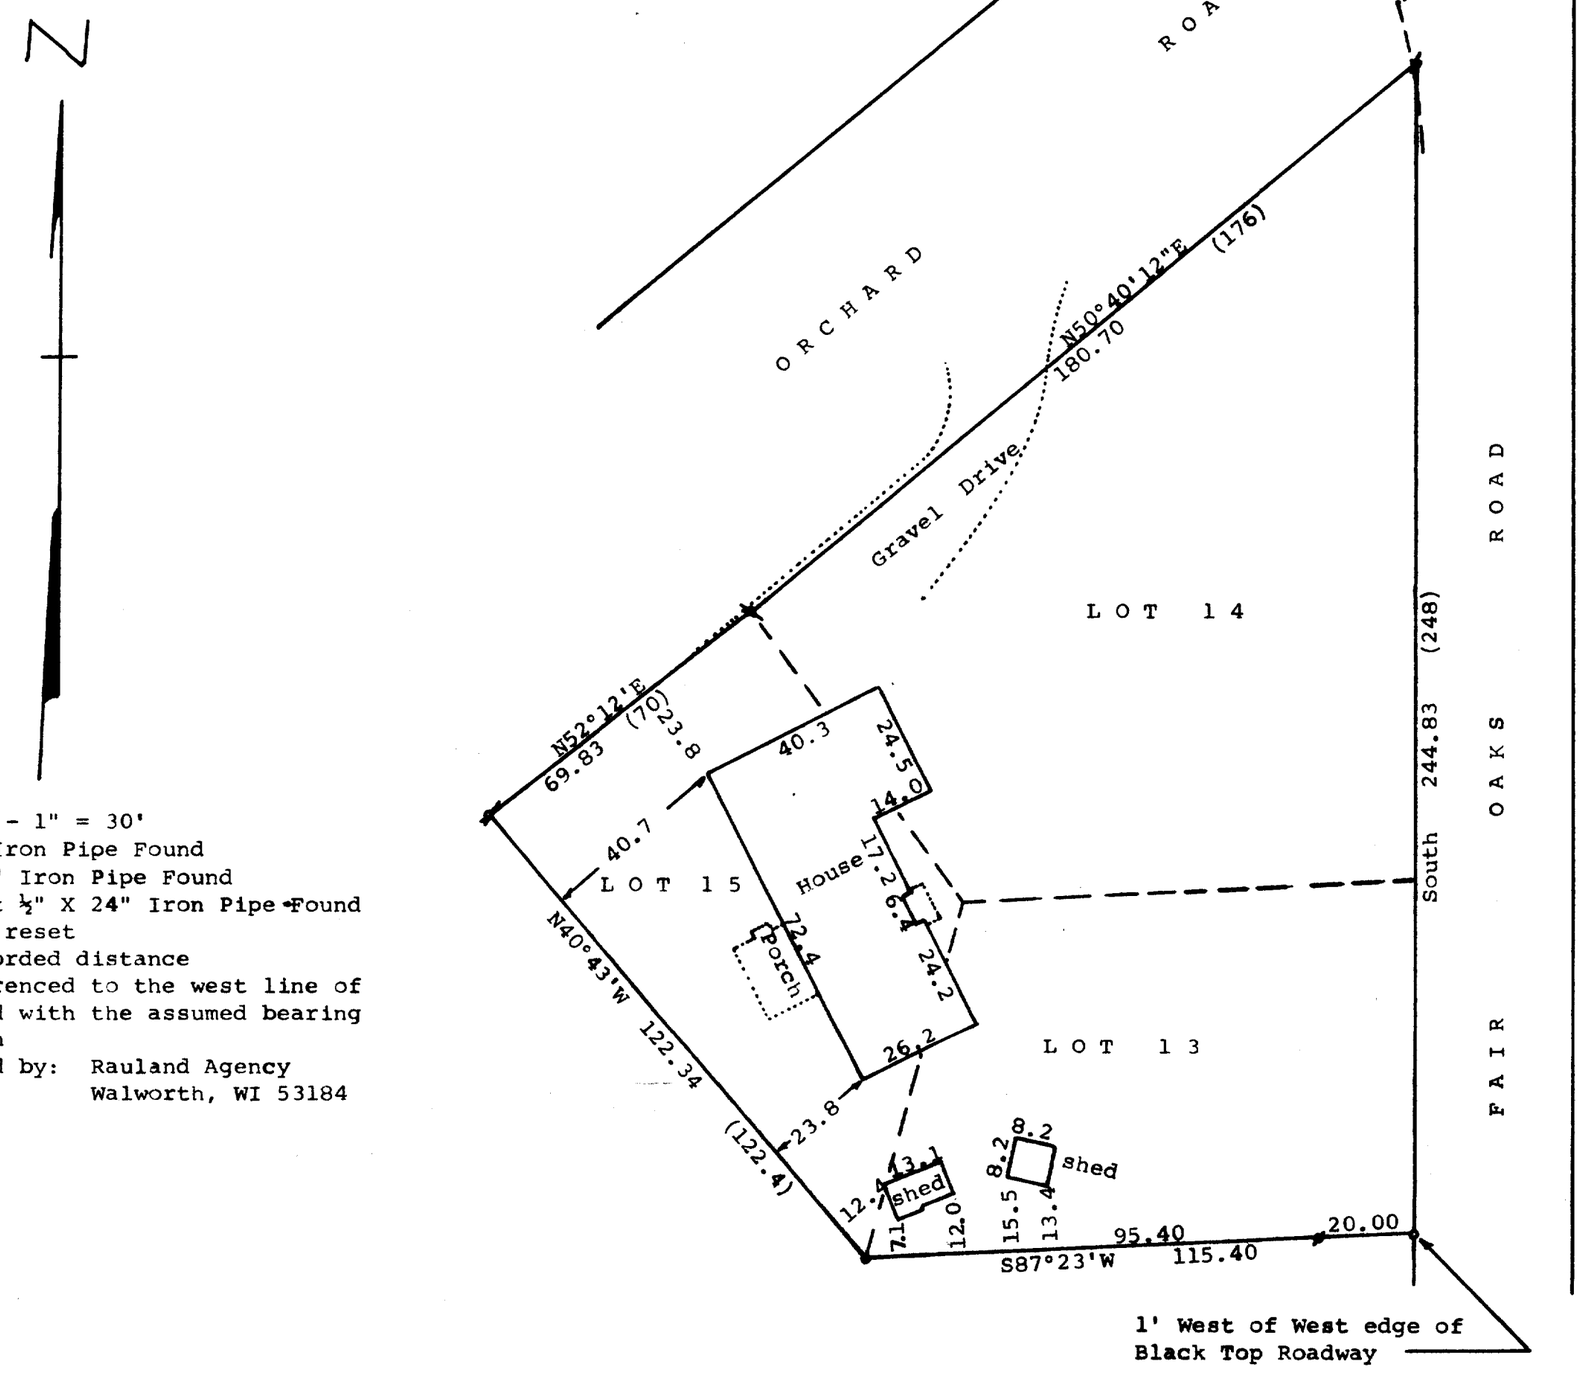

Scale - 1" = 30'
= ½" Iron Pipe Found
= 3/4" Iron Pipe Found
= Bent ½" X 24" Iron Pipe Found and reset
(0.00) = recorded distance
Bearings referenced to the west line of Fair Oaks Road with the assumed bearing of North-South
Survey ordered by: Rauland Agency
Walworth, WI 53184

STATE OF WISCONSIN)
COUNTY OF WALWORTH) SS

I, George T. Dunham, Surveyor, certify that I have surveyed the property described as follows:

Lots 13, 14, and 15, Block 10 of Wooddale Addition, a subdivision located in Fractional Section 9 and in Section 16, T 1 N, R 17 E, Walworth County, Wisconsin, and that the map shown above is a true representation thereof and shows the size and location of the property, its exterior boundaries, the location of all boundary fences, apparent easements, roadways and visible encroachments, if any, and that I have surveyed the property hereon described according to the official records, to the best of my knowledge and belief.

November 13, 1985

George T. Dunham, Surveyor

WISCONSIN
GEORGE T. DUNHAM
S-306
DELAVAN WIS.
LAND SURVEYOR

117-674-D