
WALWORTH COUNTY
SURVEYING & MAPPING
LAKE GENEVA, WISCONSIN

RECEIVED
AUG 5 1985
W. L.

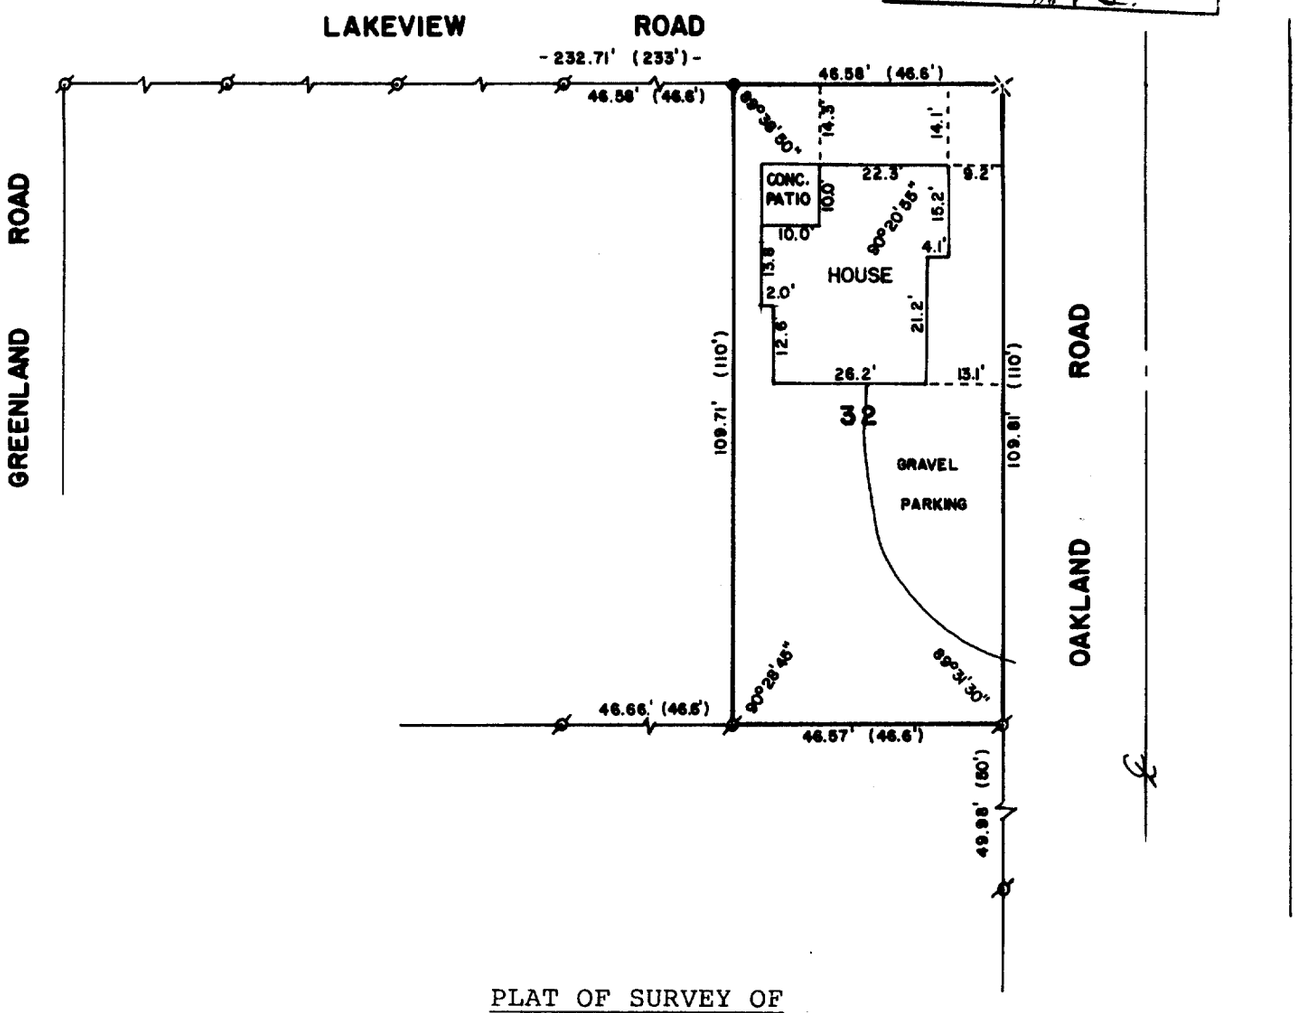

PLAT OF SURVEY OF

LOT 32 OF LAKE GENEVA HIGHLANDS, TOWN 1 NORTH, RANGE 17 EAST, WALWORTH COUNTY, WISCONSIN.

ORDERED BY: SONTAG REALTY
RT. 1, BOX 360
LAKE GENEVA, WI 53147

WISCONSIN
DAVID F. ABELL S-1596 Delavan, Wis.
LAND SURVEYOR

I, DAVID F. ABELL, DO HEREBY CERTIFY THAT I HAVE SURVEYED THE PROPERTY HEREON DESCRIBED ACCORDING TO THE OFFICIAL RECORDS, AND THAT THE PLAT HEREON IS A CORRECT REPRESENTATION OF THE PROPERTY LINES TO THE BEST OF MY KNOWLEDGE AND BELIEF.

SCALE - 1"=30'

LEGEND
ø - IRON PIPE FOUND
● - IRON ROD SET
( )- RECORDED AS
⤫ - P.K. NAIL FOUND IN CONCRETE CURB

David F. Abell
DAVID F. ABELL
WISCONSIN REGISTERED LAND SURVEYOR, S-1596

DATE July 15, 1985 JOB NUMBER 0320

1-17-695