
RECEIVED
OCT 22 1985

WALWORTH COUNTY
SURVEYING & MAPPING
LAKE GENEVA, WISCONSIN

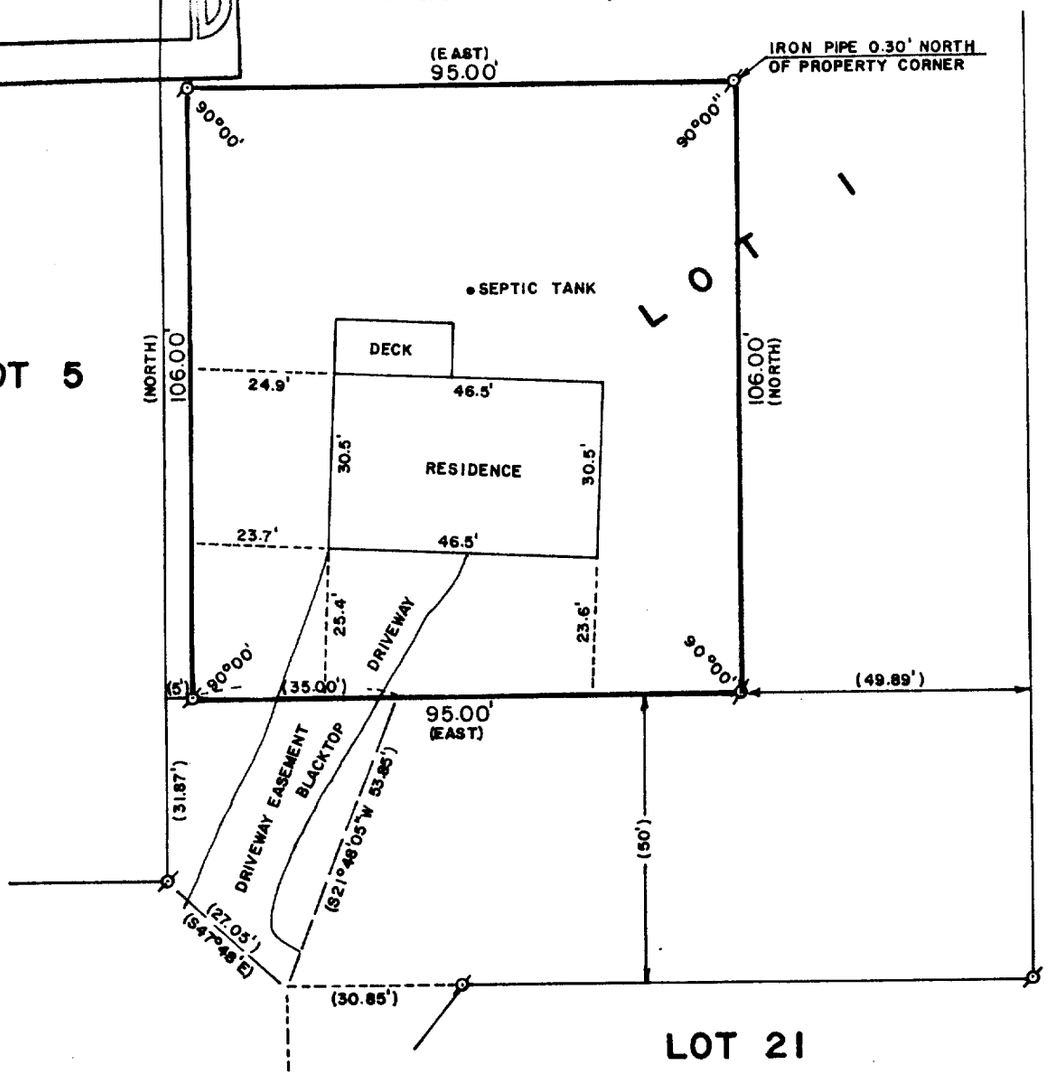

PLAT OF SURVEY OF

A PARCEL OF LAND LOCATED IN LOT 1 OF OAK SHORES SUBDIVISION DESCRIBED AS FOLLOWS: BEGINNING AT A POINT THAT IS LOCATED 50 FEET NORTH AND 49.89 FEET WEST OF THE SOUTHEAST CORNER OF SAID LOT 1, THENCE WEST 95.00 FEET; THENCE NORTH 106.00 FEET; THENCE EAST 95.00 FEET; THENCE SOUTH 106.00 FEET TO THE PLACE OF BEGINNING.

NOTE: OAK SHORES SUBDIVISION IS LOCATED IN SECTION 18, T 1 N, R 17 E, WALWORTH COUNTY, WISCONSIN.

ORDERED BY: COLDWELL BANKER
GENEVA LAKES AREA REALTORS
838 MAIN STREET
LAKE GENEVA, WISCONSIN 53147

WISCONSIN
ROBERT M. BAERENWALD
Lake Geneva, WI.
S-1508
LAND SURVEYOR

SCALE: 1"=30'

ø-IRON PIPE FOUND
()-RECORDED AS

I, ROBERT M. BAERENWALD, DO HEREBY CERTIFY THAT I HAVE SURVEYED THE PROPERTY HEREON DESCRIBED ACCORDING TO THE OFFICIAL RECORDS AND THAT THE PLAT HEREON IS A CORRECT REPRESENTATION OF THE PROPERTY LINES TO THE BEST OF MY KNOWLEDGE AND BELIEF.

Robert M. Baerenwald
ROBERT M. BAERENWALD
WISCONSIN REGISTERED LAND SURVEYOR, S-1508

Oct. 12, 1985
DATE JOB NO. 0397

I C - 1A

117-697-B