
WALWORTH COUNTY
SURVEYING & MAPPING
LAKE GENEVA, WISCONSIN

RECEIVED
OCT 2 2 1985

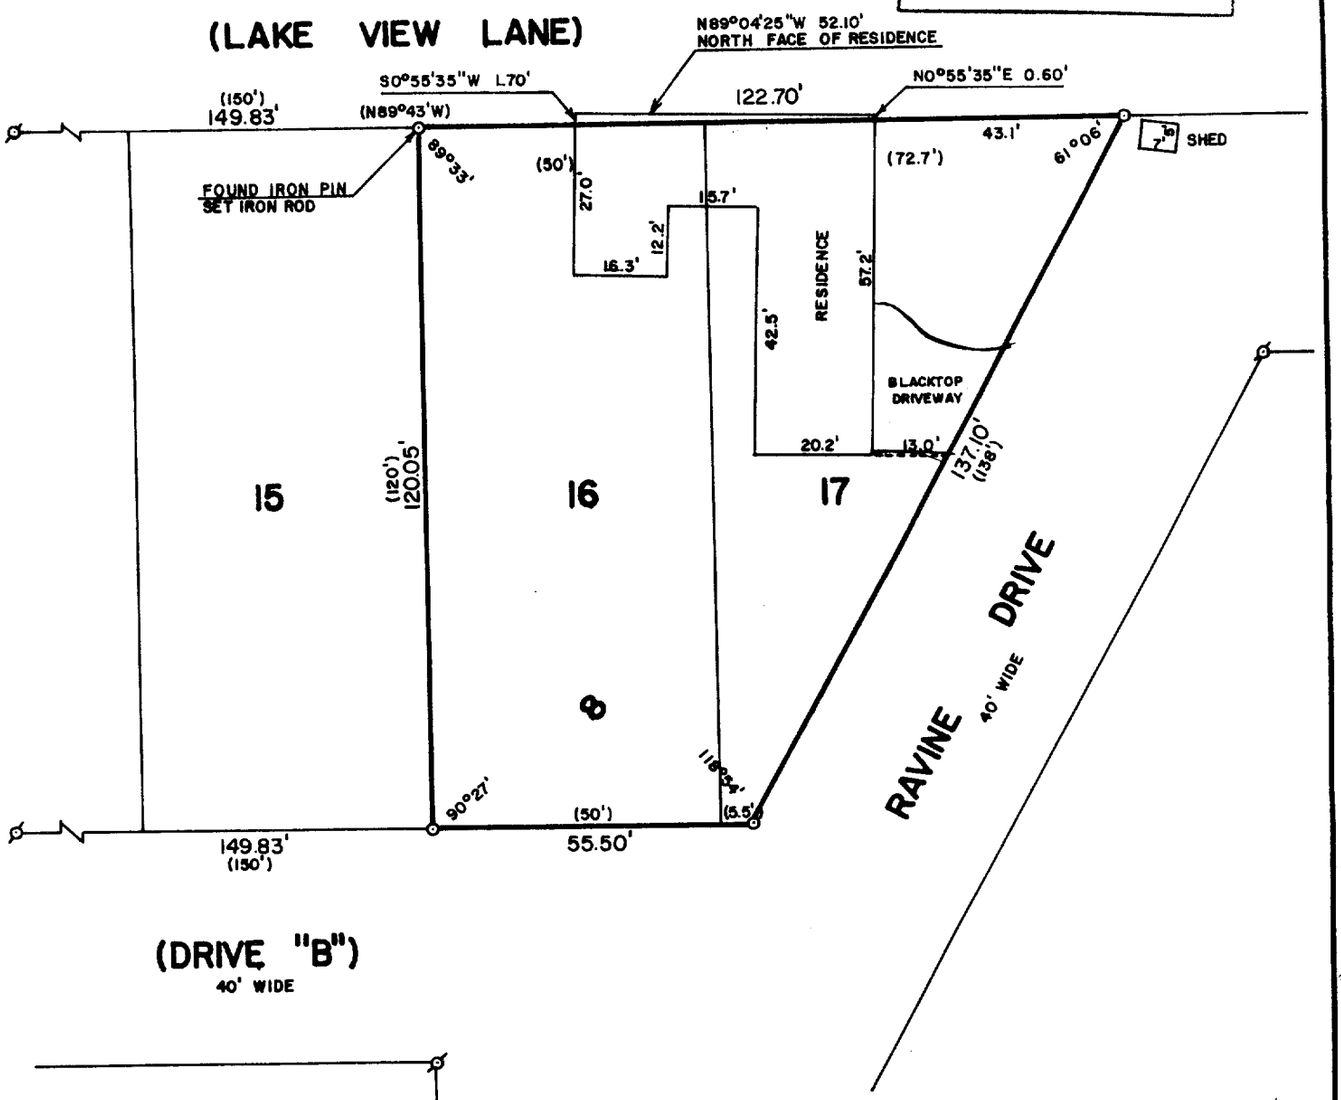

WISCONSIN
ROBERT M.
BAERENWALD
Lake Geneva, WI.
S-1508
LAND SURVEYOR

SCALE: 1"=30'

ø-IRON PIPE FOUND
o-IRON ROD PLACED
()-RECORDED AS

PLAT OF SURVEY OF

LOTS 16 AND 17, BLOCK 8 OF SUNSET HILLS, A SUBDIVISION LOCATED IN SECTION 4, T 1 N, R 17 E, WALWORTH COUNTY, WISCONSIN.

ORDERED BY: KEEFE REAL ESTATE
704 MAIN STREET
LAKE GENEVA, WISCONSIN
53147

I, ROBERT M. BAERENWALD, DO HEREBY CERTIFY THAT I HAVE SURVEYED THE PROPERTY HEREON DESCRIBED ACCORDING TO THE OFFICIAL RECORDS AND THAT THE PLAT HEREON IS A CORRECT REPRESENTATION OF THE PROPERTY LINES TO THE BEST OF MY KNOWLEDGE AND BELIEF.

Robert M. Baerenwald
ROBERT M. BAERENWALD
WISCONSIN REGISTERED LAND SURVEYOR, S-1508

Aug. 6, 1985
DATE JOB NO. 0333

REVISED DATE: AUG. 22, 1985

I SH - 00114

117-698-B

WALWORTH COUNTY
SURVEYING & MAPPING
727 HENRY STREET
LAKE GENEVA, WISCONSIN 53147

OCT 2 2 1985

DESCRIPTION OF


A PARCEL OF LAND LOCATED IN THE SOUTHWEST 1/4 OF SECTION 33, T 2 N, R 17 E, WALWORTH COUNTY, WISCONSIN BEING A PART OF LAKE VIEW LANE OF LAKE GENEVA KNOLL SUBDIVISION, DESCRIBED AS FOLLOWS: COMMENCING AT THE NORTHEAST CORNER OF LOT 17, BLOCK 8 OF SUNSET HILLS SUBDIVISION, THENCE N89°00'00"W, ALONG THE NORTHERLY LINE OF SAID BLOCK 8, 43.10 FEET TO THE PLACE OF BEGINNING; THENCE N0°55'35"E 0.60 FEET; THENCE N89°04'25"W 52.10 FEET; THENCE S0°55'35"W 1.70 FEET TO THE NORTHERLY LINE OF SAID BLOCK 8; THENCE S89°43'00"E 52.11 FEET TO THE PLACE OF BEGINNING.

Robert M. Baerenwald

ROBERT M. BAERENWALD
WISCONSIN REGISTERED LAND SURVEYOR, S-1508

Aug. 22, 1985

DATE JOB NO. 0333

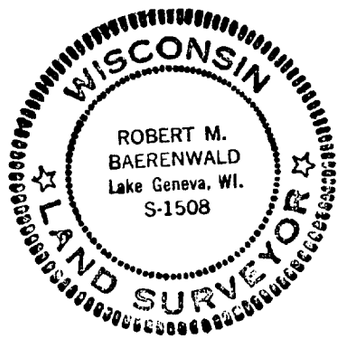

217-698B