
RECEIVED
SEP 30 1985

KOLB LAND CONSULTING, INC.

LAND SURVEYING · SUBDIVIDING · LAND PLANNING

929 WILLIAMS STREET LAKE GENEVA, WISCONSIN 53147 414-248-3697

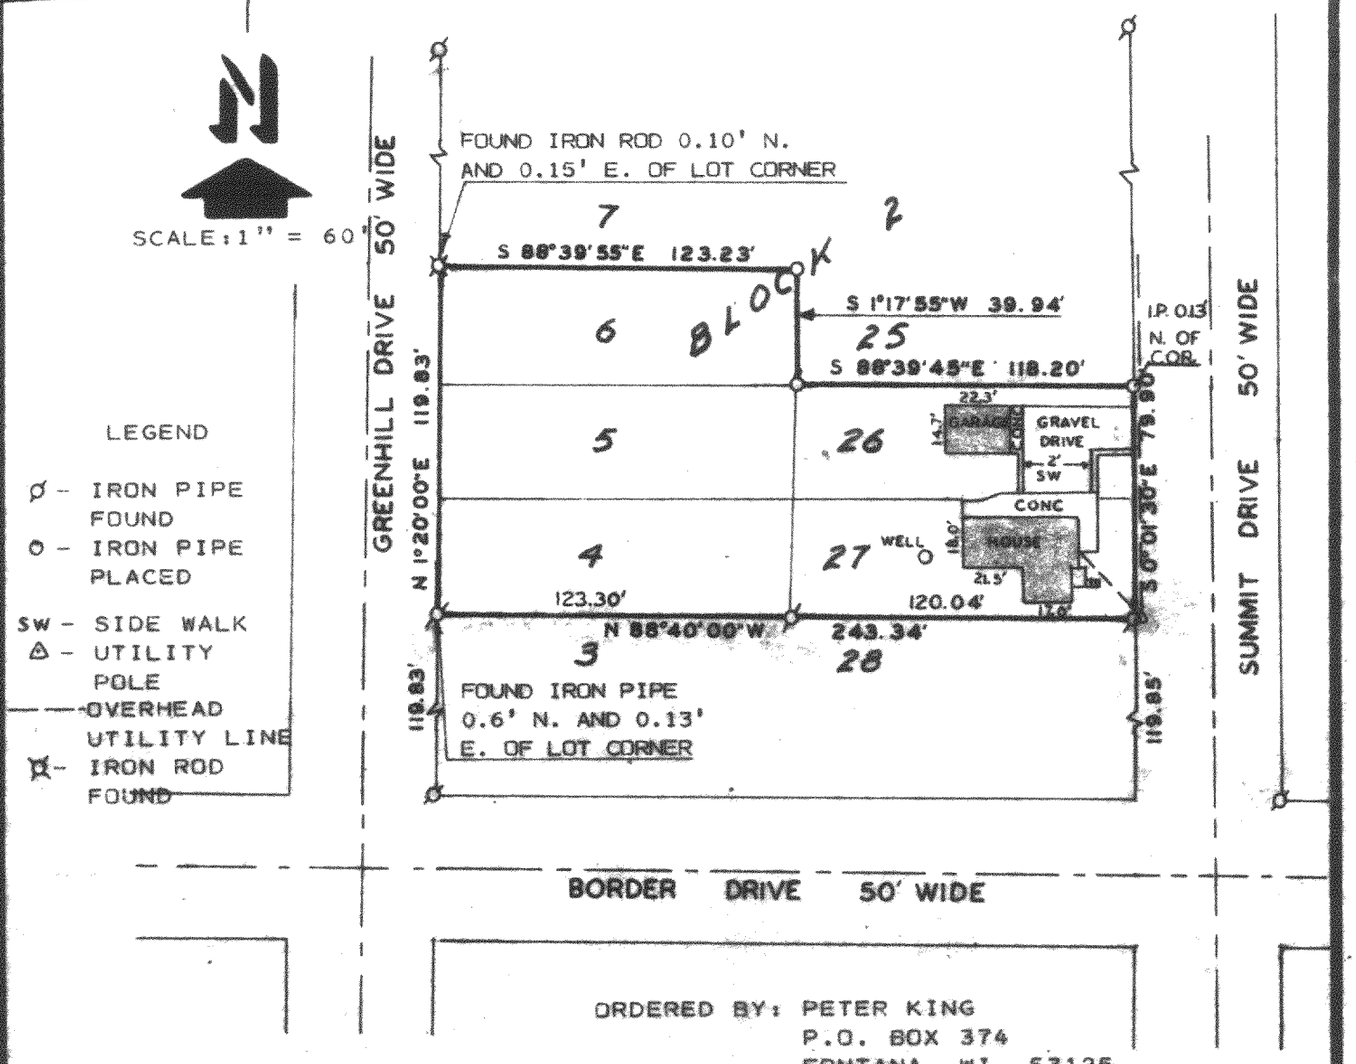

ORDERED BY: PETER KING
P.O. BOX 374
FONTANA, WI. 53125

PLAT OF SURVEY OF

LOTS 4, 5, 6, 26 AND 27, BLOCK 2, MAPLE HILLS "A", A SUBDIVISION LOCATED IN SECTION 18, T 1 N, R 17 E, TOWN OF LINN, WALWORTH COUNTY, WISCONSIN.

NOTE; BEARINGS ARE ASSUMED THE SOUTH LINE OF BLOCK 2 IS AS SHOWN ON THE RECORDED PLAT.

I HEREBY CERTIFY THAT I HAVE SURVEYED THE ABOVE DESCRIBED PROPERTY AND THAT THE ABOVE MAP IS A TRUE REPRESENTATION THEREOF AND SHOWS THE SIZE AND LOCATION OF THE PROPERTY, IT'S EXTERIOR BOUNDARIES, THE LOCATION OF ALL VISIBLE STRUCTURES AND DIMENSIONS OF ALL PRINCIPAL BUILDINGS THEREON, BOUNDRY FENCES, APPARENT EASEMENTS, ROADWAYS AND VISIBLE ENCROACHMENTS, IF ANY, TO THE BEST OF MY KNOWLEDGE AND BELIEF.
THIS SURVEY IS MADE FOR THE USE OF THE PRESENT OWNERS OF THE PROPERTY, AND ALSO THOSE WHO PURCHASE, MORTGAGE, OR GUARANTEE THE TITLE THERETO WITHIN ONE (1) YEAR FROM DATE THEREOF.

WISCONSIN HAROLD H. KOLB S-187 LAKE GENEVA, WIS. LAND SURVEYOR

Harold H. Kolb
HAROLD H. KOLB

WISCONSIN REGISTERED LAND SURVEYOR, S-187

DATE JULY 24, 1985

REVISED

REVISED

117-698-K

1-17 IMH 15, 16 F 35