


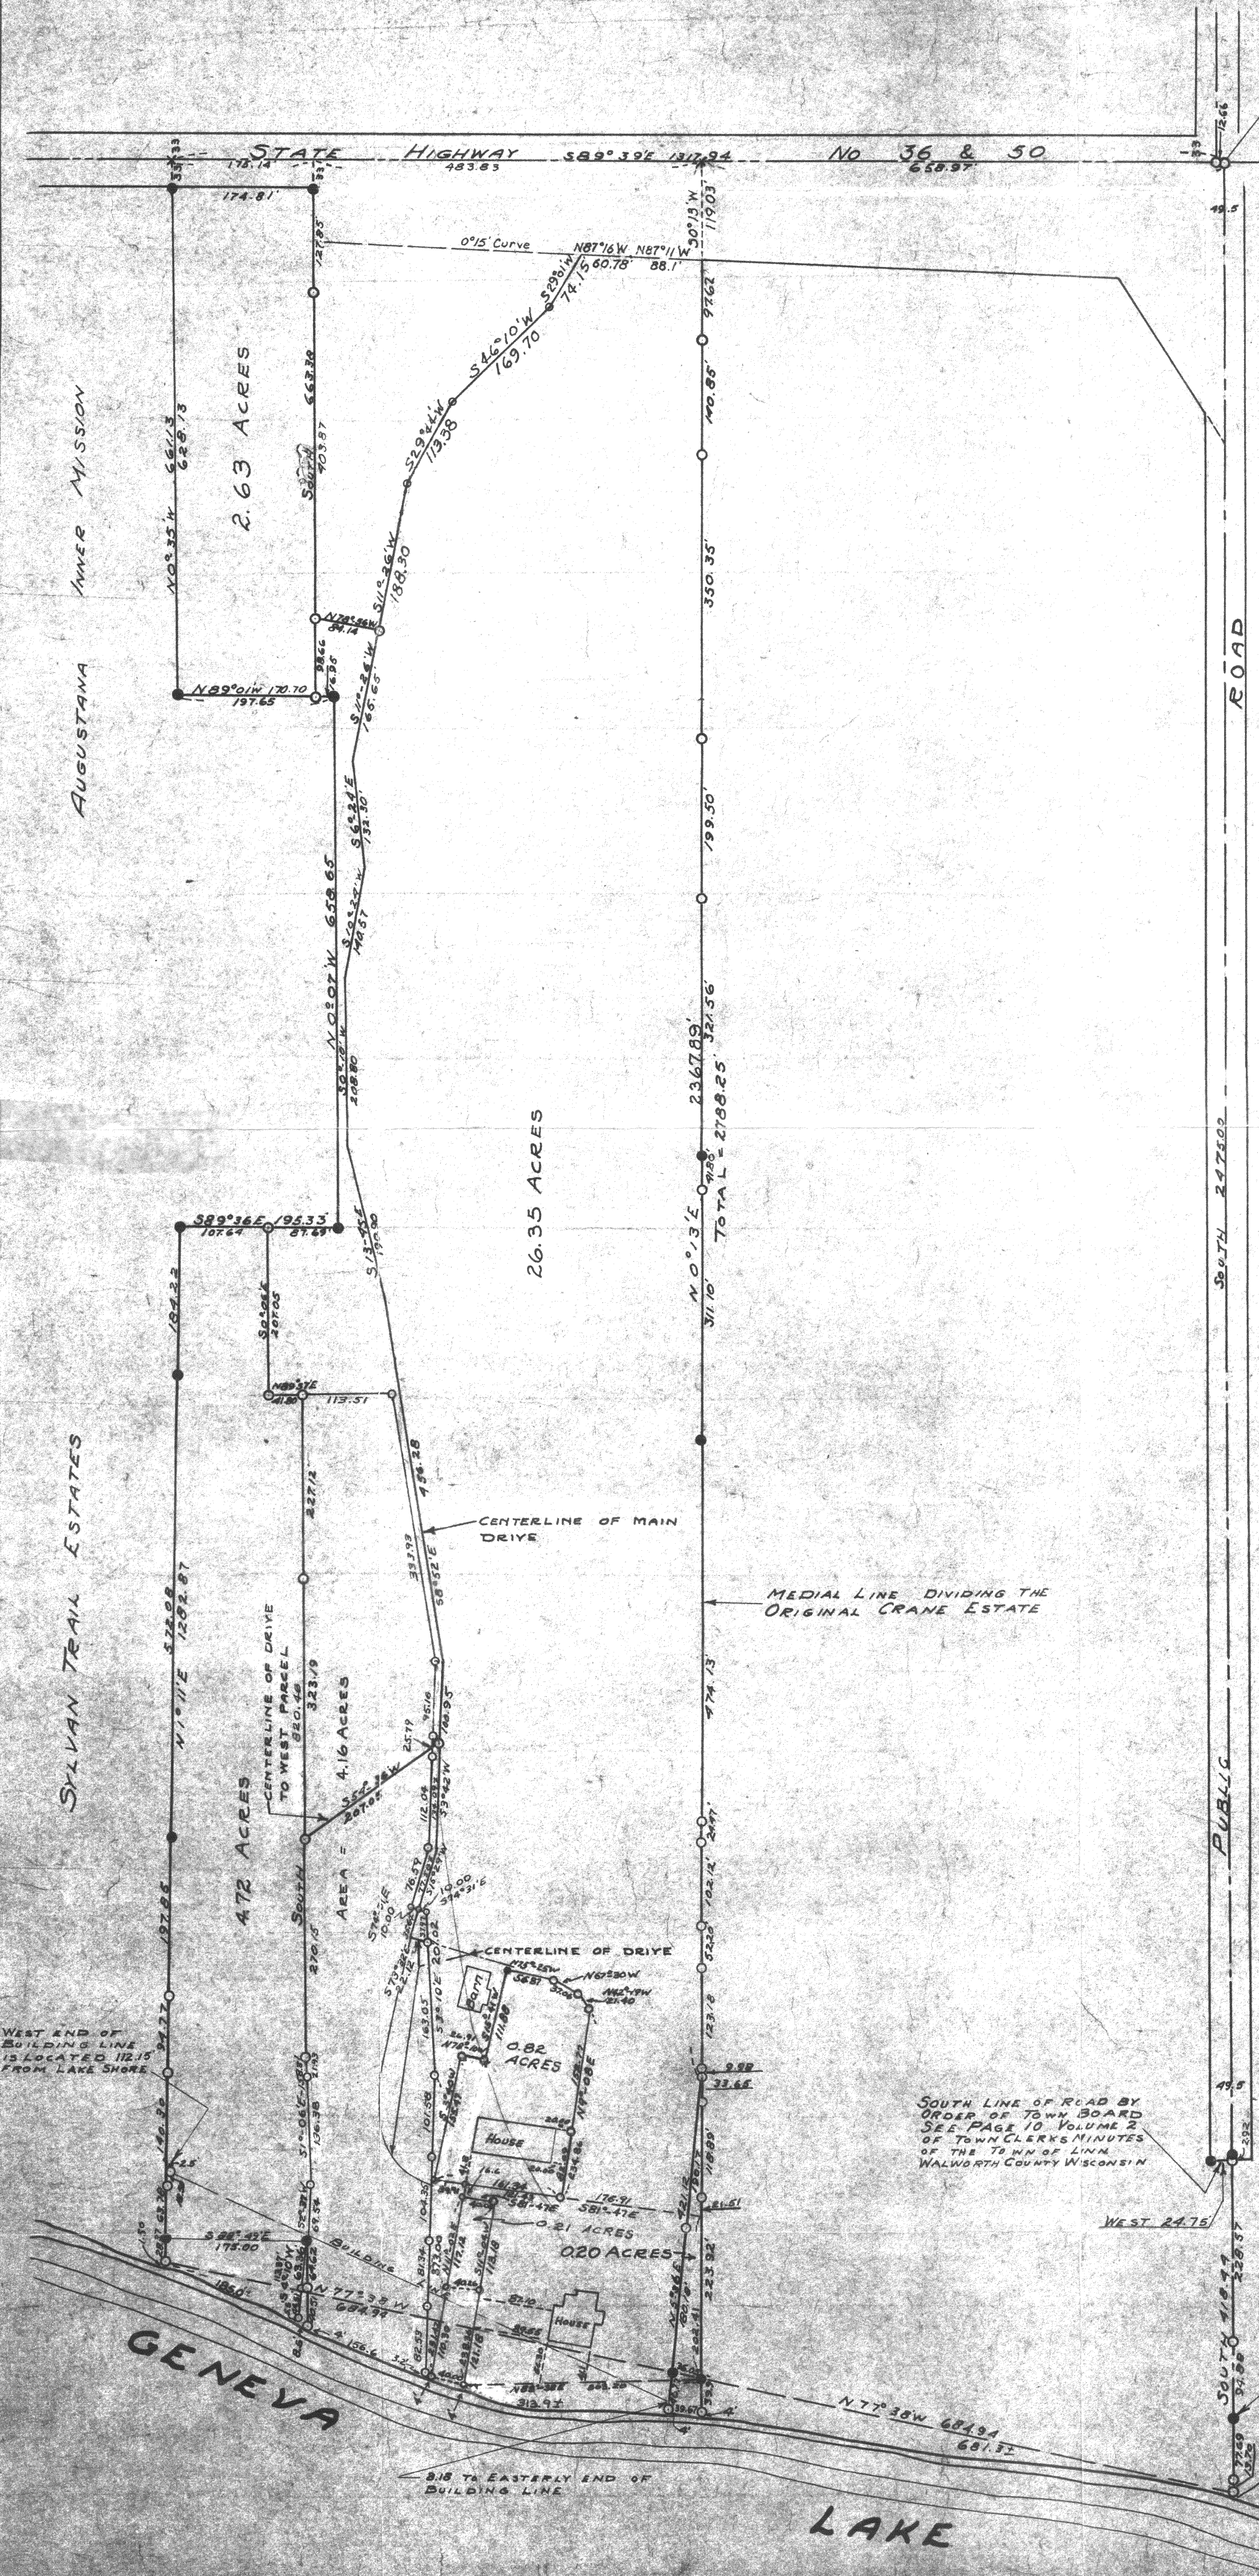

NORTHEAST CORNER OF SECTION 5 TIN RITE WALWORTH COUNTY, WISC.

SCALE 1" = 100'
X = CROSS IN CONC.
O = IRON PIPE
● = CONCRETE MONU.

PLAT OF SURVEY OF LAND
LOCATED IN THE EAST 1/2 OF FRACTIONAL
SECTION 5 TIN RITE OF WALWORTH
COUNTY, WISCONSIN

APRIL, 1948
Revised - March, 1961
Revised - September, 1961
Revised - October, 1963

Rogers Jensen
COUNTY SURVEYOR

SOUTH LINE OF ROAD BY
ORDER OF TOWN BOARD
SEE PAGE 10, VOLUME 2
OF TOWN CLERK'S MINUTES
OF THE TOWN OF LINN
WALWORTH COUNTY, WISCONSIN

ELGIN CLUB SUBD.

EAST 1/4 CORNER OF
SECTION 5 TIN RITE
WALWORTH COUNTY, WISC.