KOLB LAND CONSULTING, INC.

LAND SURVEYING · SUBDIVIDING · LAND PLANNING


929 WILLIAMS STREET LAKE GENEVA, WISCONSIN 53147 414-248-3697

SCALE: 1" = 40'

LEGEND

- ⌀ - IRON PIPE FOUND
- ○ - 1-1/4" X 24' IRON PIPE SET
- △ - UTILITY POLE
- —— —— - OVERHEAD UTILITY LINE
- SW - SIDE WALK
- ⬡ - UTILITY PEDISTAL
- ( ) - AS RECORDED
- ■ - STONE MONUMENT FOUND

ORDERED BY: RICHARD CAIN
3RD AVE.
FONTANA, WI. 53125

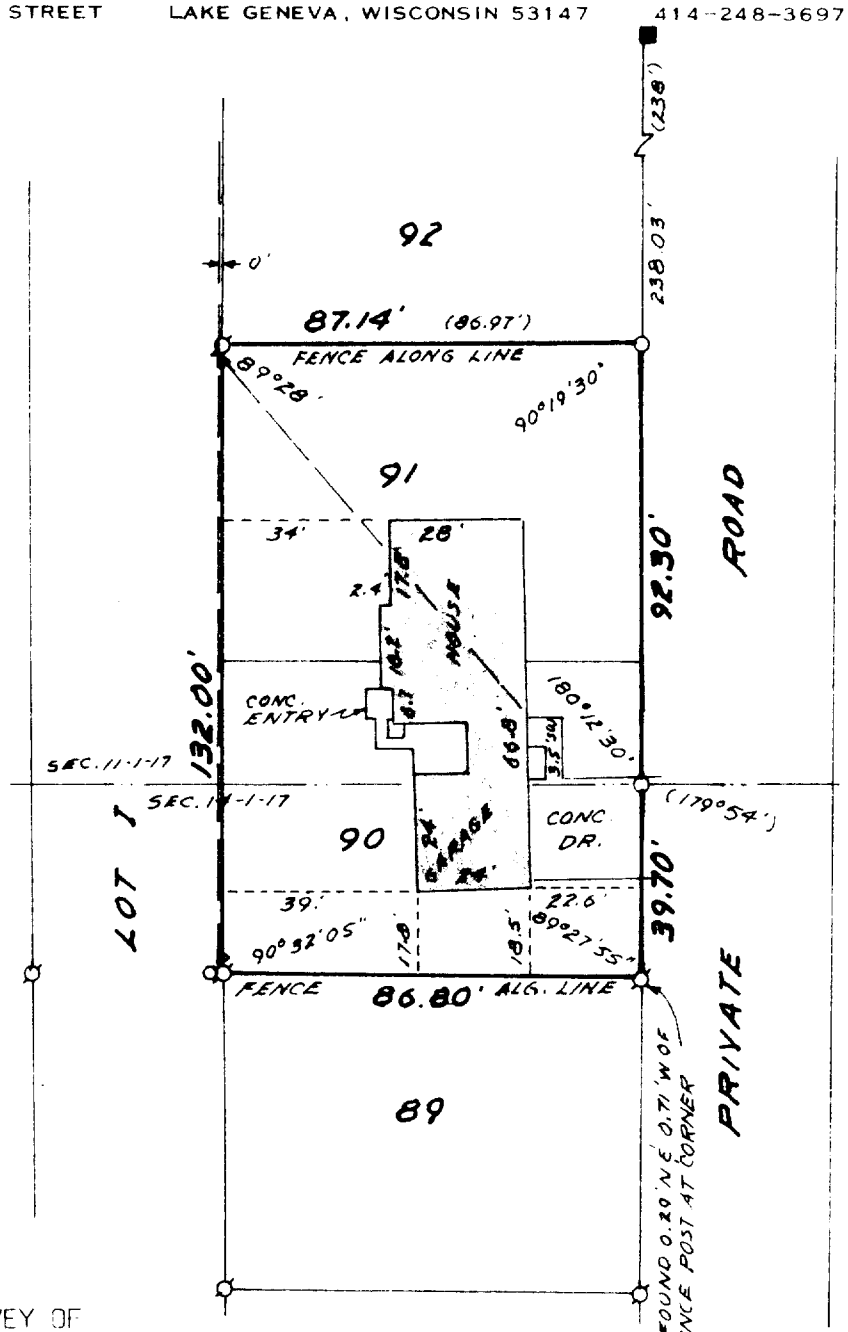

RECEIVED
NOV 13 1986

PLAT OF SURVEY OF

LOTS 90 AND 91 OF ROBINSON'S 2ND ADDITION, LOCATED IN SECTION 11 AND SECTION 14, T1N, R17E, TOWN OF LINN, WALWORTH COUNTY, WISCONSIN.

I HEREBY CERTIFY THAT I HAVE SURVEYED THE ABOVE DESCRIBED PROPERTY AND THAT THE ABOVE MAP IS A TRUE REPRESENTATION THEREOF AND SHOWS THE SIZE AND LOCATION OF THE PROPERTY, ITS EXTERIOR BOUNDARIES, THE LOCATION OF ALL VISIBLE STRUCTURES AND DIMENSIONS OF ALL PRINCIPAL BUILDINGS THEREON, BOUNDARY FENCES, APPARENT EASEMENTS, ROADWAYS AND VISIBLE ENCROACHMENTS, IF ANY, TO THE BEST OF MY KNOWLEDGE AND BELIEF.
THIS SURVEY IS MADE FOR THE USE OF THE PRESENT OWNERS OF THE PROPERTY AND ALSO THOSE WHO PURCHASE, MORTGAGE, OR GUARANTEE THE TITLE THERETO WITHIN ONE (1) YEAR FROM DATE HEREOF.

Harold H. Kolb

HAROLD H. KOLB

WISCONSIN REGISTERED LAND SURVEYOR, S-187

DATE JUNE 17, 1986

REVISED

REVISED

1RB2-71

117.794K