
WALWORTH COUNTY
SURVEYING & MAPPING
LAKE GENEVA, WISCONSIN

NOTE: IRON PIPE 0.43 FEET WEST OF LOT CORNER AS SHOWN ON EXISTING SURVEY RECORDS.

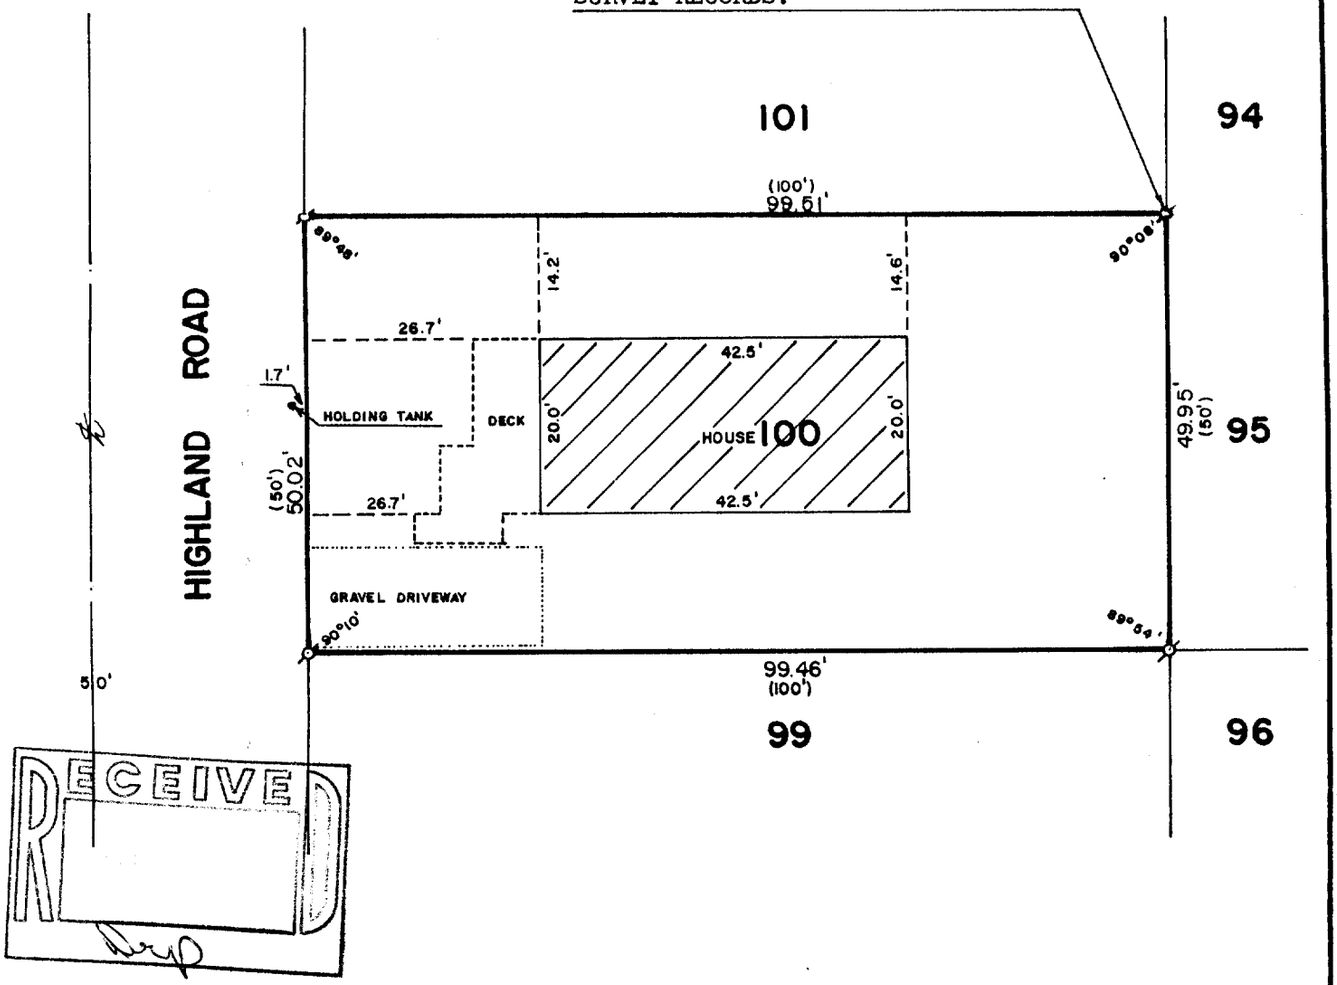

RECEIVED

PLAT OF SURVEY OF

LOT 100 OF LAKE GENEVA HIGHLANDS, A SUBDIVISION LOCATED IN SECTION 8, T 1 N, R 17 E, WALWORTH COUNTY, WISCONSIN.

ORDERED BY: GENEVA LAKEFRONT REALTY
50 WEST GENEVA STREET
WILLIAMS BAY, WISCONSIN

SCALE: 1"=20'

ø -IRON PIPE FOUND
()-RECORDED AS

I, ROBERT M. BAERENWALD, DO HEREBY CERTIFY THAT I HAVE SURVEYED THE PROPERTY HEREON DESCRIBED ACCORDING TO THE OFFICIAL RECORDS AND THAT THE PLAT HEREON IS A CORRECT REPRESENTATION OF THE PROPERTY LINES TO THE BEST OF MY KNOWLEDGE AND BELIEF.

Robert M. Baerenwald
ROBERT M. BAERENWALD
WISCONSIN REGISTERED LAND SURVEYOR, S-1508

Aug. 5, 1986
DATE JOB NO. 0739

NOTE: THIS IS NOT A CERTIFIED COPY UNLESS SEALED.

ILGH-97

117-762B