
WALWORTH COUNTY
SURVEYING & MAPPING
LAKE GENEVA, WISCONSIN

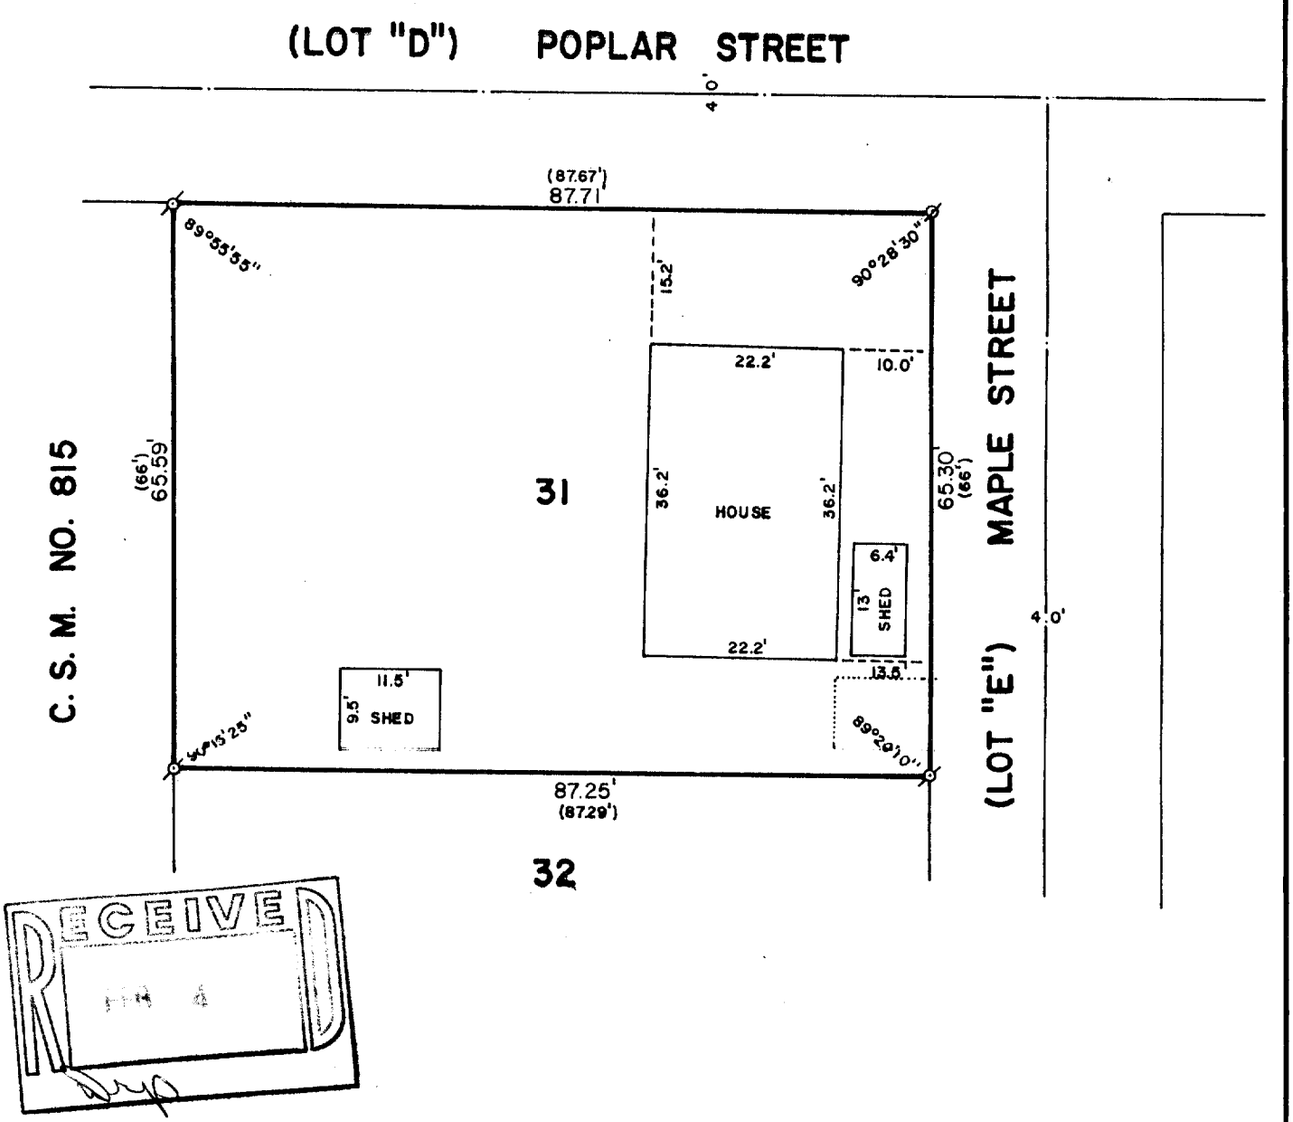

RECEIVED
SEP 4
Sontag

PLAT OF SURVEY OF

LOT 31 OF ROBINSON'S 2ND SUBDIVISION,
LOCATED IN SECTIONS 11 AND 14, T 1 N,
R 17 E, WALWORTH COUNTY, WISCONSIN.

ORDERED BY: SONTAG REALTY
RT. 1, BOX 360
LAKE GENEVA, WISCONSIN 53147

SCALE: 1"=30'

ø -IRON PIPE FOUND
ø -IRON ROD FOUND
( )-RECORDED AS

I, ROBERT M. BAERENWALD, DO HEREBY CERTIFY THAT I HAVE SURVEYED THE PROPERTY HEREON DESCRIBED ACCORDING TO THE OFFICIAL RECORDS AND THAT THE PLAT HEREON IS A CORRECT REPRESENTATION OF THE PROPERTY LINES TO THE BEST OF MY KNOWLEDGE AND BELIEF.

Robert M. Baerenwald
ROBERT M. BAERENWALD
WISCONSIN REGISTERED LAND SURVEYOR, S-1508

Sept. 29, 1986
DATE JOB NO. 0661

NOTE: THIS IS NOT A CERTIFIED COPY UNLESS SEALED.

IRB2-26

117-763