
WALWORTH COUNTY
SURVEYING & MAPPING
LAKE GENEVA, WISCONSIN

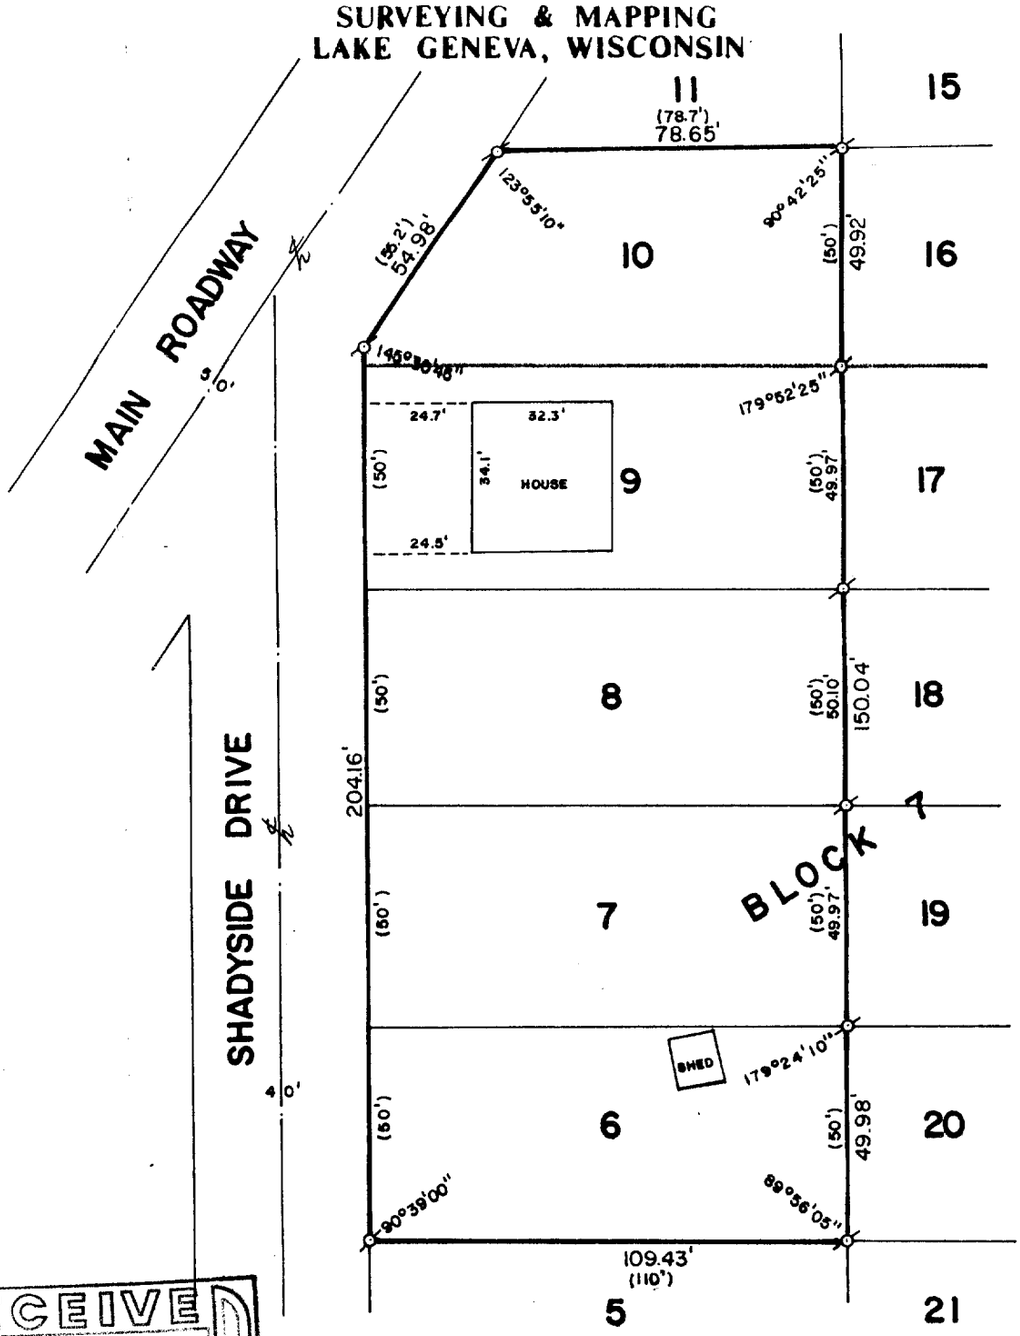

RECEIVED

PLAT OF SURVEY OF

LOTS 6-10, BLOCK 7 OF SUNSET HILLS, A SUBDIVISION LOCATED IN SECTION 4, T 1 N, R 17 E, WALWORTH COUNTY, WISCONSIN.

ORDERED BY: KEEFE REAL ESTATE
704 MAIN STREET
LAKE GENEVA, WISCONSIN 53147

SCALE: 1"=40'

ø-IRON PIPE FOUND
()-RECORDED AS

I, ROBERT M. BAERENWALD, DO HEREBY CERTIFY THAT I HAVE SURVEYED THE PROPERTY HEREON DESCRIBED ACCORDING TO THE OFFICIAL RECORDS AND THAT THE PLAT HEREON IS A CORRECT REPRESENTATION OF THE PROPERTY LINES TO THE BEST OF MY KNOWLEDGE AND BELIEF.

Robert M. Baerenwald
ROBERT M. BAERENWALD
WISCONSIN RECISTERED LAND SURVEYOR, S-1508

Sept. 30, 1986
DATE JOB NO. 0768

NOTE: THIS IS NOT A CERTIFIED COPY UNLESS SEALED.

ISH-89

117-763B