
KOLB LAND CONSULTING, INC.

LAND SURVEYING · SUBDIVIDING · LAND PLANNING

929 WILLIAMS STREET LAKE GENEVA, WISCONSIN 53147 414-248-3697

RECEIVED
SEP 16 1987

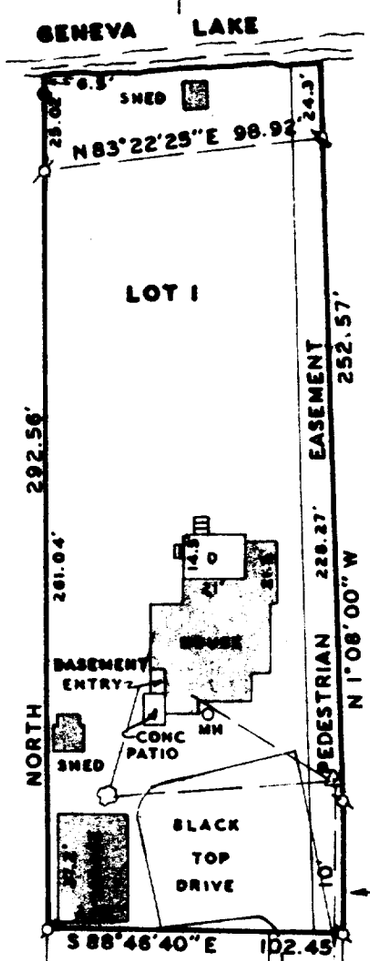

SCALE: 1" = 60'

LEGEND

- ∅ - IRON PIPE FOUND
- ● - CONCRETE MONUMENT
- ( ) - AS RECORDED
- △ - UTILITY POLE
- —— —— - OVERHEAD UTILITY LINE
- TREE
- MH - MANHOLE
- D - DECK

ORDERED BY

LAKESHORE REAL ESTATE
101 BROAD STREET
LAKE GENEVA, WI. 53147

PLAT OF SURVEY OF

LOT 1 OF CERTIFIED SURVEY MAP NO. 483, LOCATED IN THE NORTHWEST 1/4 OF SECTION 12, T1N, R17E, TOWN OF LINN, WALWORTH COUNTY, WISCONSIN.

I HEREBY CERTIFY THAT I HAVE SURVEYED THE ABOVE DESCRIBED PROPERTY AND THAT THE ABOVE MAP IS A TRUE REPRESENTATION THEREOF AND SHOWS THE SIZE AND LOCATION OF THE PROPERTY, ITS EXTERIOR BOUNDARIES, THE LOCATION OF ALL VISIBLE STRUCTURES AND DIMENSIONS OF ALL PRINCIPAL BUILDINGS THEREON, BOUNDARY FENCES, APPARENT EASEMENTS, ROADWAYS AND VISIBLE ENCROACHMENTS, IF ANY, TO THE BEST OF MY KNOWLEDGE AND BELIEF.
THIS SURVEY IS MADE FOR THE USE OF THE PRESENT OWNERS OF THE PROPERTY AND ALSO THOSE WHO PURCHASE MORTGAGE, OR GUARANTEE THE TITLE THERETO WITHIN ONE (1) YEAR FROM DATE HEREOF.

Harold H. Kolb

HAROLD H. KOLB

WISCONSIN REGISTERED LAND SURVEYOR, S-137

DATE NOVEMBER 10, 1986

REVISED

REVISED

NOTE: BEARINGS ARE ASSUMED AS SHOWN ON CSM # 483.

IA 483-1

117-933

~~1-17-158~~