


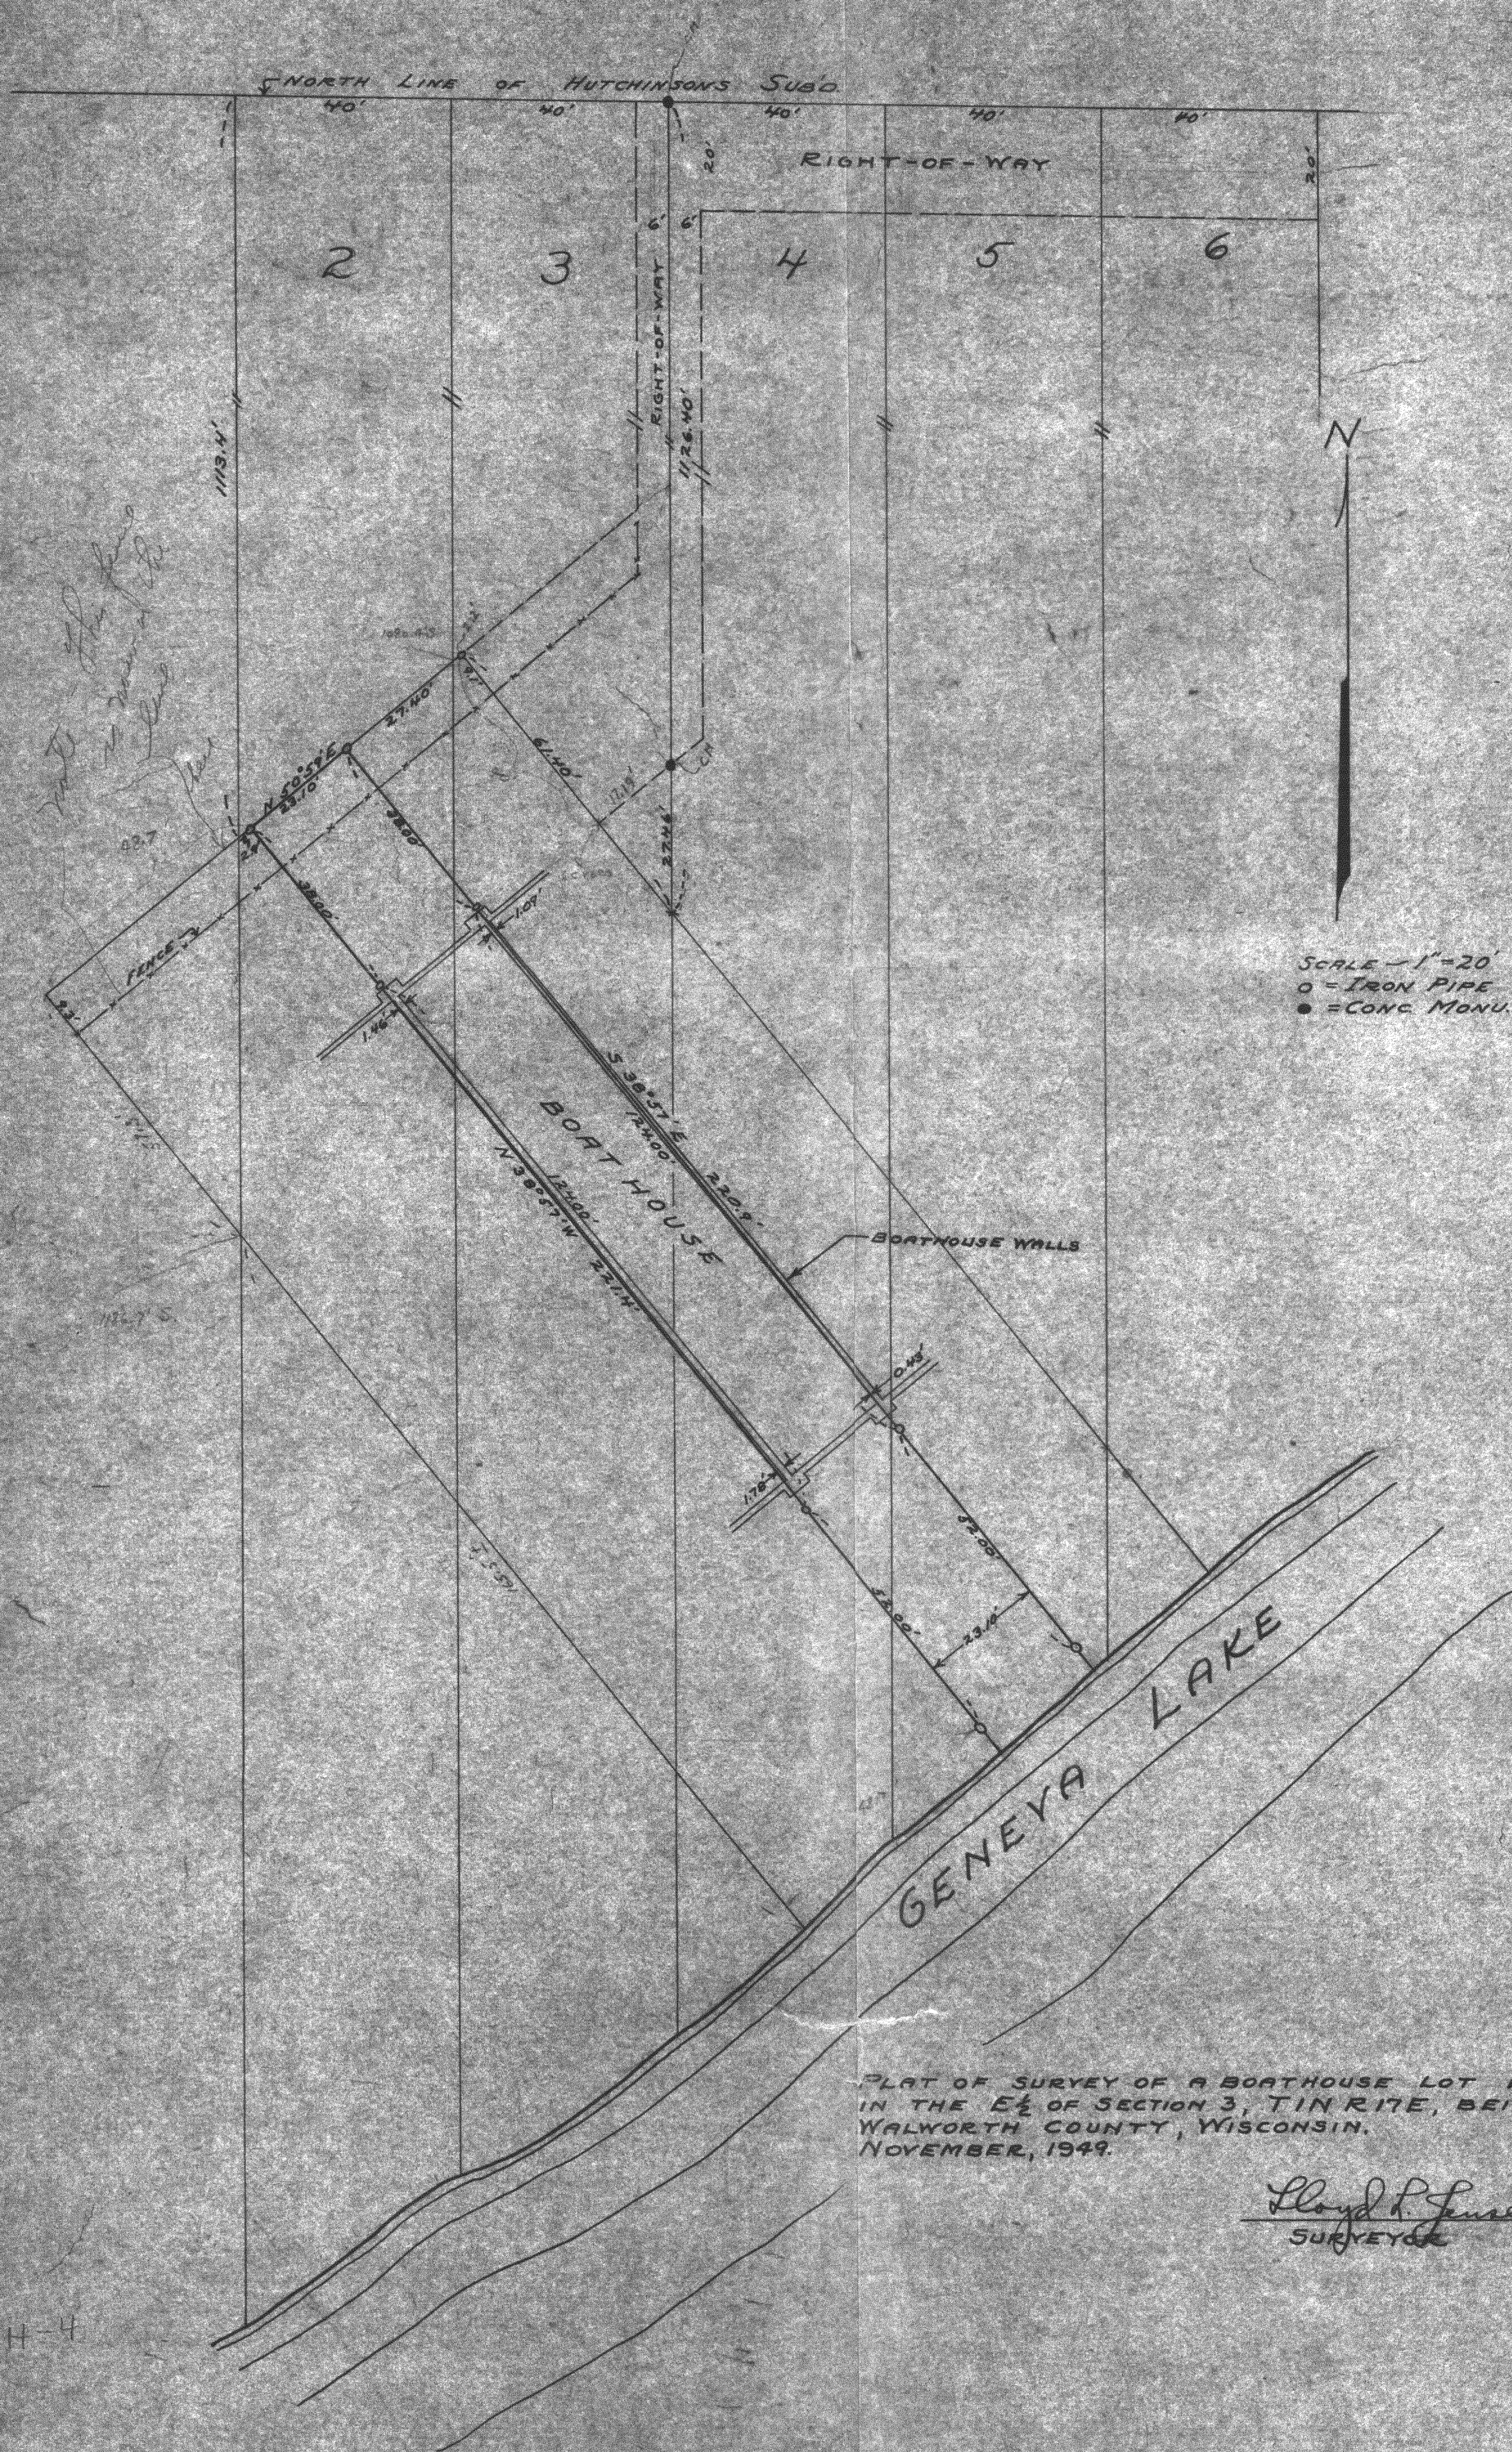

PLAT OF SURVEY OF A BOATHOUSE LOT LOCATED
IN THE E $\frac{1}{2}$ OF SECTION 3, T1N R1E, BEING IN
WALWORTH COUNTY, WISCONSIN.
NOVEMBER, 1949.

Lloyd P. Jensen
SURVEYOR