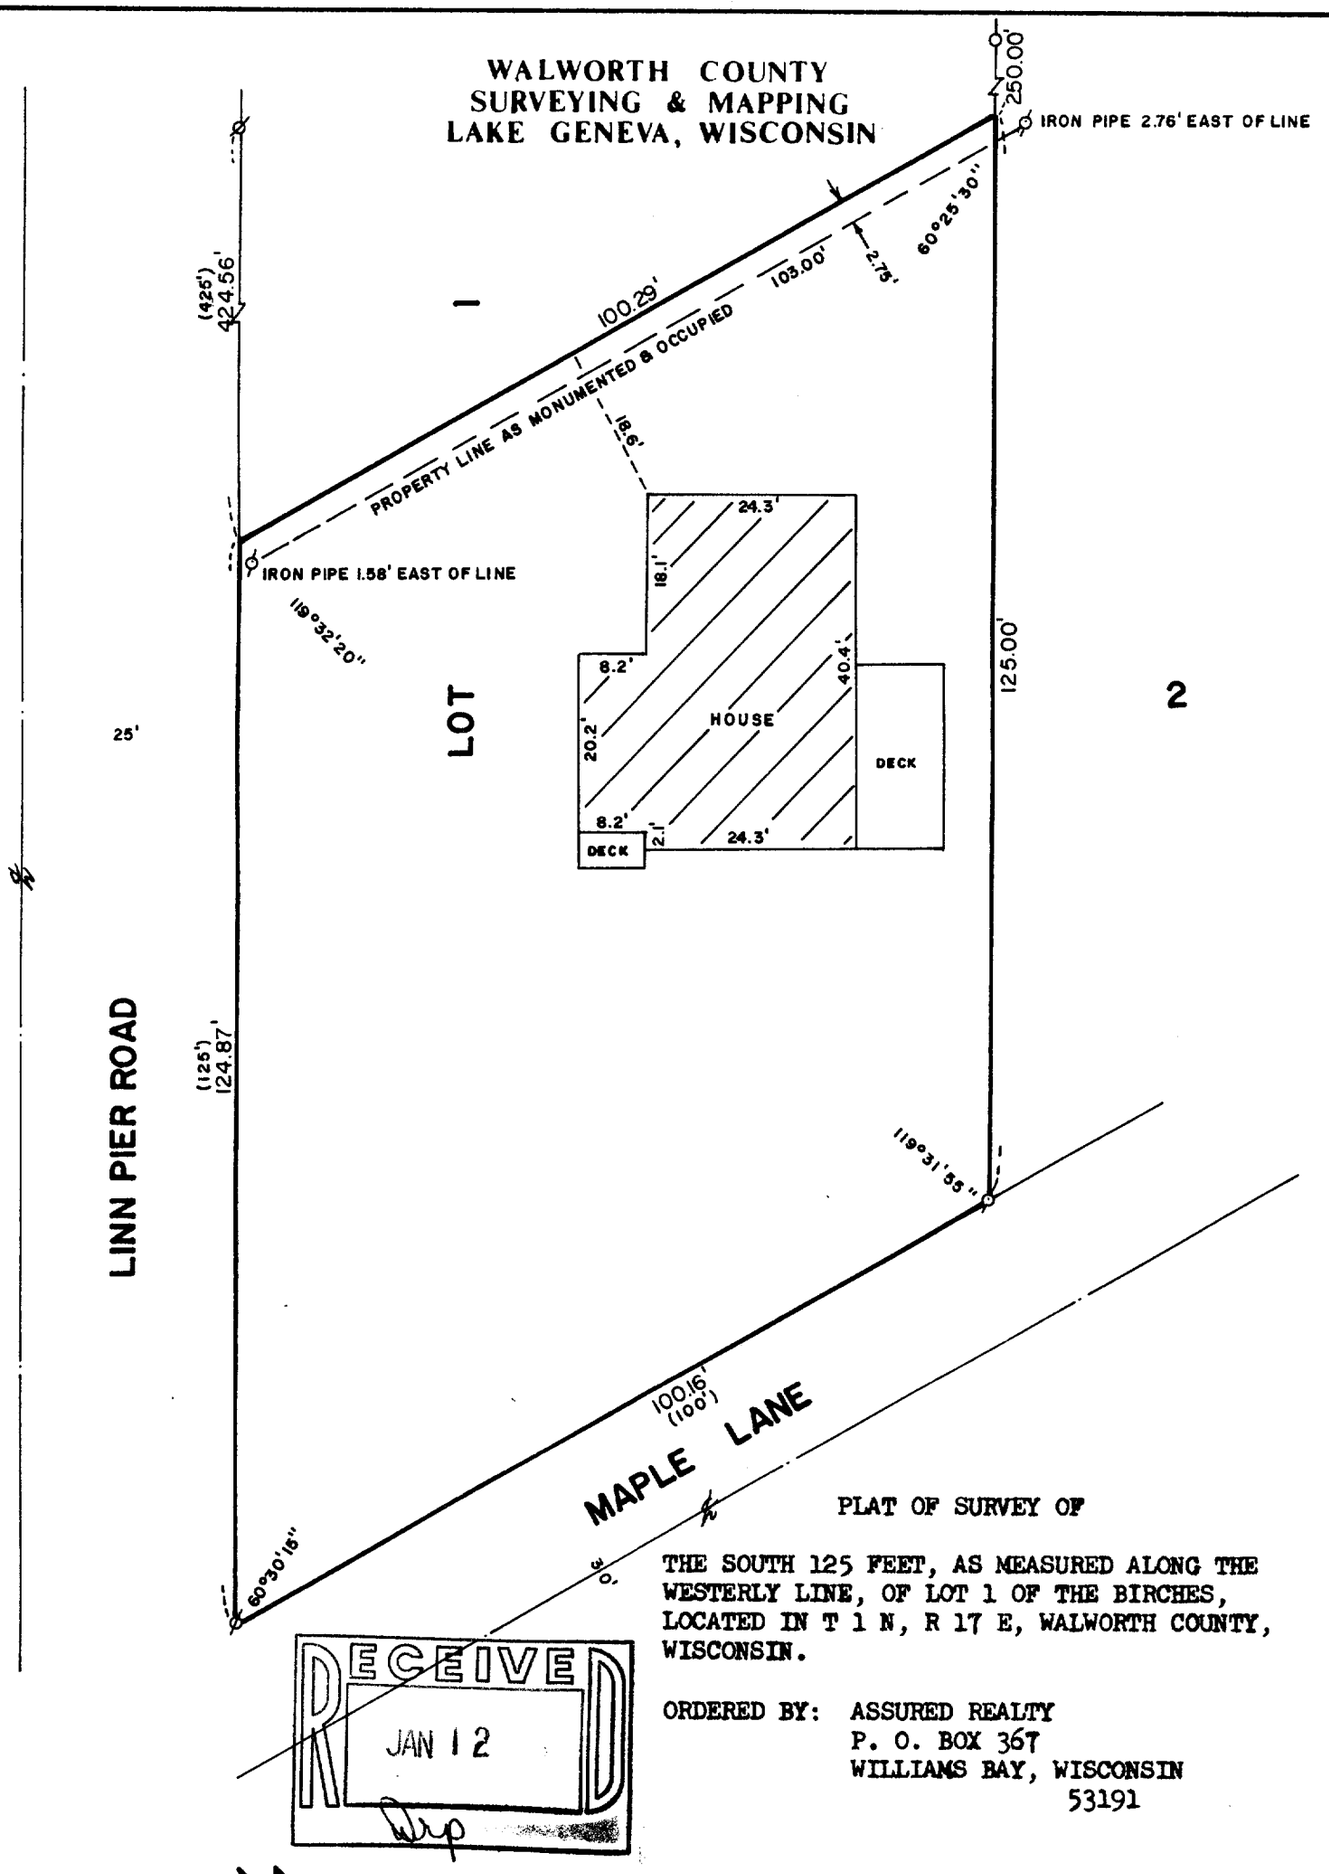


RECEIVED
JAN 12

PLAT OF SURVEY OF

THE SOUTH 125 FEET, AS MEASURED ALONG THE WESTERLY LINE, OF LOT 1 OF THE BIRCHES, LOCATED IN T 1 N, R 17 E, WALWORTH COUNTY, WISCONSIN.

ORDERED BY: ASSURED REALTY
P. O. BOX 367
WILLIAMS BAY, WISCONSIN
53191

SCALE: 1"=20'

ø -IRON PIPE FOUND
ø -AXEL ROD FOUND
( )-RECORDED AS

I, ROBERT M. BAERENWALD, DO HEREBY CERTIFY THAT I HAVE SURVEYED THE PROPERTY HEREON DESCRIBED ACCORDING TO THE OFFICIAL RECORDS AND THAT THE PLAT HEREON IS A CORRECT REPRESENTATION OF THE PROPERTY LINES TO THE BEST OF MY KNOWLEDGE AND BELIEF.

Robert M. Baerenwald
ROBERT M. BAERENWALD
WISCONSIN REGISTERED LAND SURVEYOR, S-1508

Nov. 6, 1987
DATE JOB NO. 1304

NOTE: THIS IS NOT A CERTIFIED COPY UNLESS SEALED.

117-8563