
WALWORTH COUNTY
SURVEYING & MAPPING
LAKE GENEVA, WISCONSIN

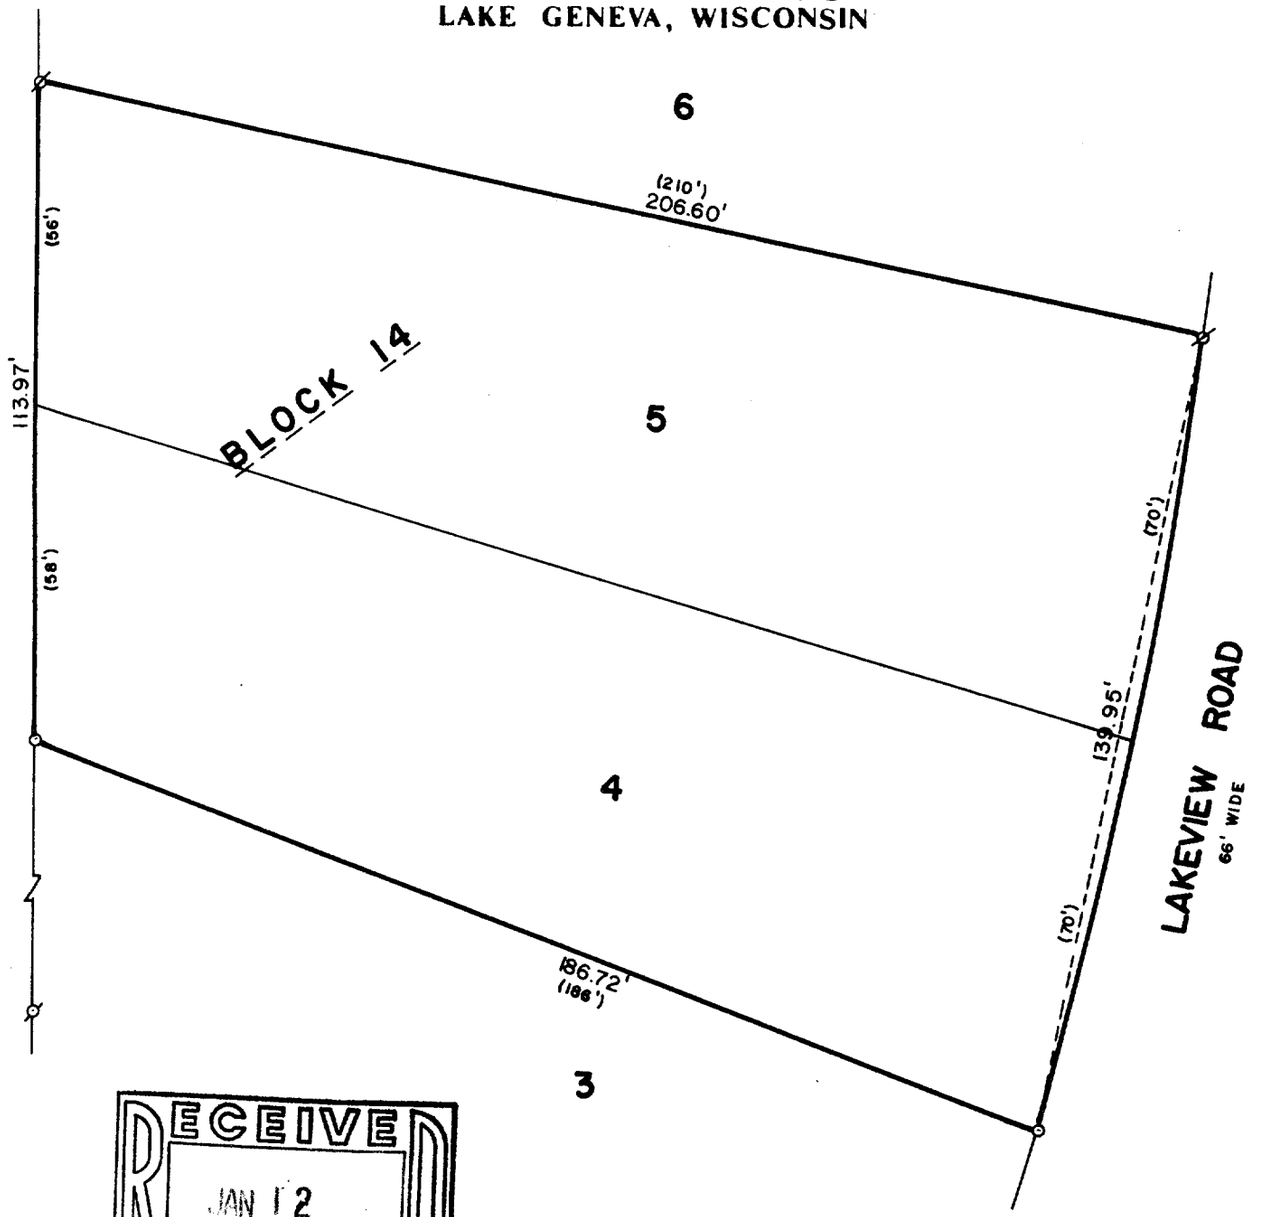

RECEIVED
JAN 12

PLAT OF SURVEY OF

LOTS 4 AND 5, BLOCK 14 OF WOODDALE ADDITION, LOCATED IN T 1 N, R 17 E, WALWORTH COUNTY, WISCONSIN.

ORDERED BY: BETTY SYVER
P. O. BOX 631
LAKE GENEVA, WISCONSIN
53147

SCALE: 1"=30'

ø -IRON PIPE FOUND
ø -IRON ROD FOUND
o -IRON ROD PLACED
( )-RECORDED AS

I, ROBERT M. BAERENWALD, DO HEREBY CERTIFY THAT I HAVE SURVEYED THE PROPERTY HEREON DESCRIBED ACCORDING TO THE OFFICIAL RECORDS AND THAT THE PLAT HEREON IS A CORRECT REPRESENTATION OF THE PROPERTY LINES TO THE BEST OF MY KNOWLEDGE AND BELIEF.

Robert M. Baerenwald
ROBERT M. BAERENWALD
WISCONSIN REGISTERED LAND SURVEYOR, S-1508

Dec. 19, 1987
DATE JOB NO. 1333

NOTE: THIS IS NOT A CERTIFIED COPY UNLESS SEALED.

117-857