
WALWORTH COUNTY
SURVEYING & MAPPING
LAKE GENEVA, WISCONSIN

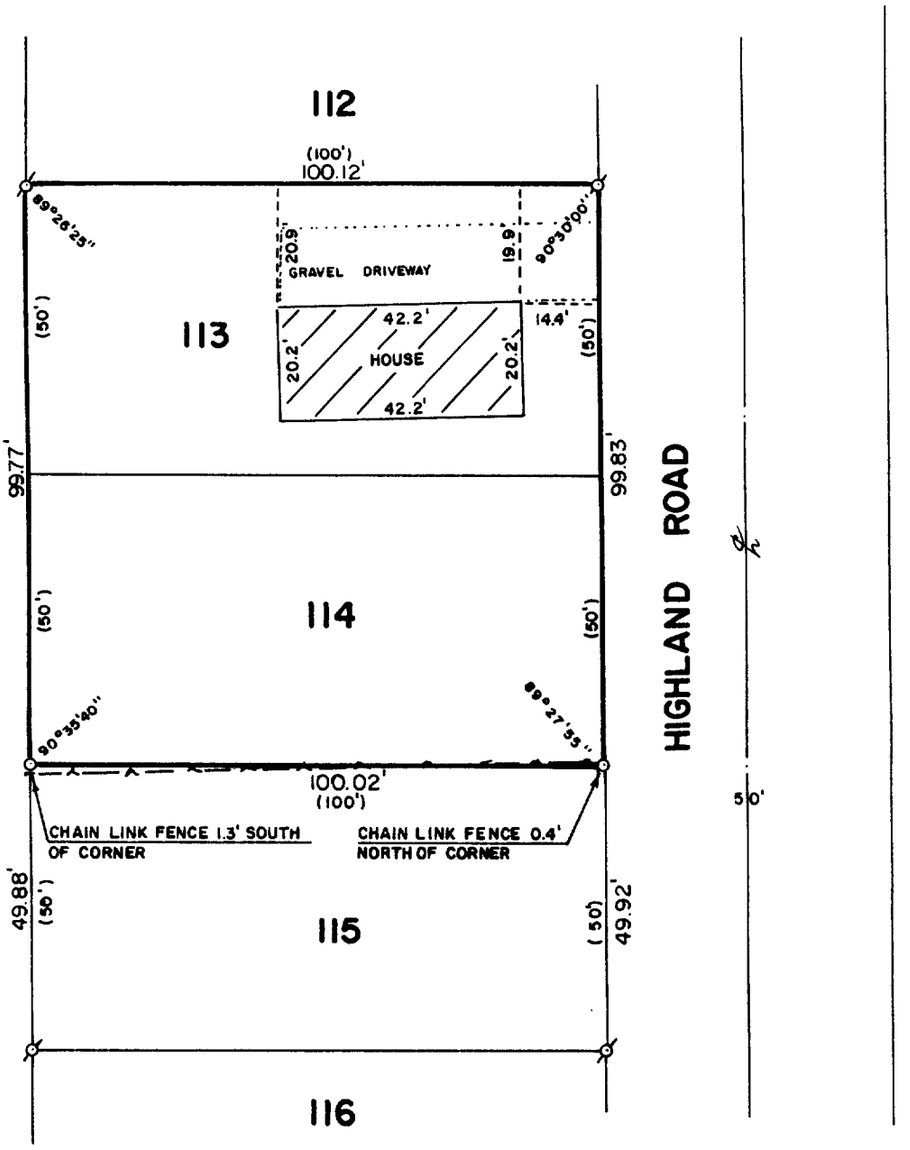

PLAT OF SURVEY OF

LOTS 113 AND 114 OF LAKE GENEVA HIGHLANDS, LOCATED IN T 1 N, R 17 E, WALWORTH COUNTY, WISCONSIN.

RECEIVED
JUN 17 1988

ORDERED BY: SONTAG REALTY
SOUTH SHORE DRIVE & BB
LAKE GENEVA, WISCONSIN
53147

N

SCALE: 1"=30'

ø -IRON PIPE FOUND
o -IRON ROD PLACED
( )-RECORDED AS

I, ROBERT M. BAERENWALD, DO HEREBY CERTIFY THAT I HAVE SURVEYED THE PROPERTY HEREON DESCRIBED ACCORDING TO THE OFFICIAL RECORDS AND THAT THE PLAT HEREON IS A CORRECT REPRESENTATION OF THE PROPERTY LINES TO THE BEST OF MY KNOWLEDGE AND BELIEF.

Robert M. Baerenwald
ROBERT M. BAERENWALD
WISCONSIN REGISTERED LAND SURVEYOR, S-1508

May 22, 1988
DATE JOB NO. 1537

NOTE: THIS IS NOT A CERTIFIED COPY UNLESS SEALED.

T1GH-110, 111

117-891