
KOLB LAND CONSULTING, INC.

LAND SURVEYING · SUBDIVIDING · LAND PLANNING

929 WILLIAMS STREET LAKE GENEVA, WISCONSIN 53147 414-248-3697

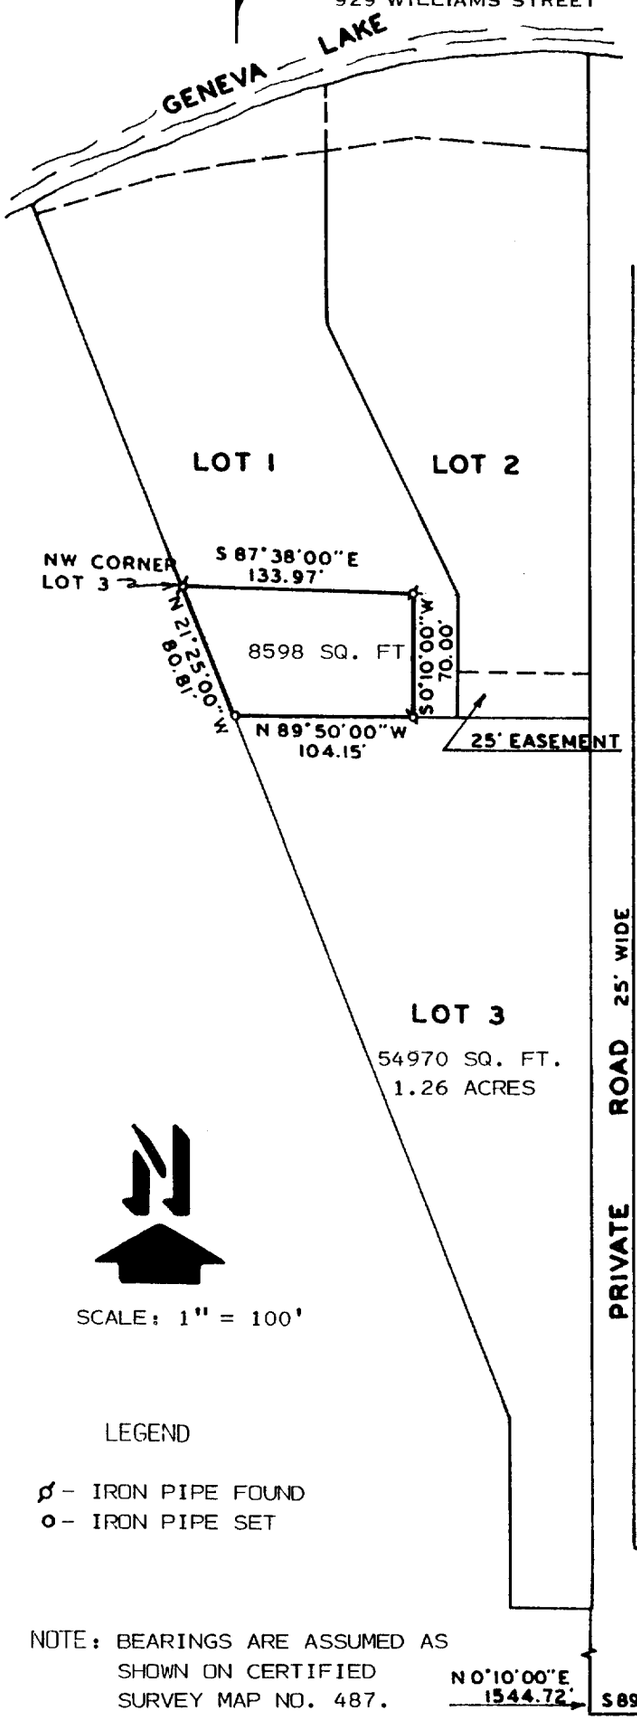

ORDERED BY: FRANK LIVINGSTON
306 E. ASH
CHATSWORTH, IL.60921-0205

DESCRIPTION OF LOT LINE ADJUSTMENT

A PART OF LOT 3, CERTIFIED SURVEY MAP NUMBER 487, LOCATED IN THE SOUTHWEST 1/4 OF SECTION 9, T1N, R17E, TOWN OF LINN, WALWORTH COUNTY, WISCONSIN AND DESCRIBED AS FOLLOWS;
BEGINNING AT THE NORTHWEST CORNER OF SAID LOT 3;
THENCE S 87°38'00" E 133.97 FEET;
THENCE S 0°10'00" W 70.00 FEET;
THENCE N 89°50'00" W 104.15 FEET;
THENCE N 21°25'00" W 80.81 FEET TO THE PLACE OF BEGINNING.
AND CONTAINING 0.20 ACRES.

NOTE: THIS IS A LOT LINE ADJUSTMENT.

I, HAROLD H. KOLB, DO HEREBY CERTIFY THAT I HAVE SURVEYED THE PROPERTY HEREON DESCRIBED ACCORDING TO THE OFFICIAL RECORDS AND THAT THE PLAT HEREON IS A CORRECT REPRESENTATION OF THE LOT LINES TO THE BEST OF MY KNOWLEDGE AND BELIEF.

SURVEY NOT VALID UNLESS SURVEYOR'S SIGNATURE IS IN RED.

SCALE: 1" = 100'

LEGEND

- ⌀ - IRON PIPE FOUND
- o - IRON PIPE SET

NOTE: BEARINGS ARE ASSUMED AS SHOWN ON CERTIFIED SURVEY MAP NO. 487.

RECEIVED
MAR 14 1989

HAROLD H. KOLB

WISCONSIN REGISTERED LAND SURVEYOR, S-187

DATE OCTOBER 19, 1988

REVISED

REVISED

117-95)

1-17-330