
ABELL
SURVEYING & MAPPING
DELAVAN, WISCONSIN 53115
414-728-6737

PLAT OF SURVEY OF

LOT 3, BLOCK 1, WOODDALE ADDITION, LOCATED IN T1N,R17E, WALWORTH COUNTY, WISCONSIN.

ORDERED BY: RAY WE DYCK (OWNER)
221 S. PRINDLE
ARLINGTON HEIGHTS, IL.
60004

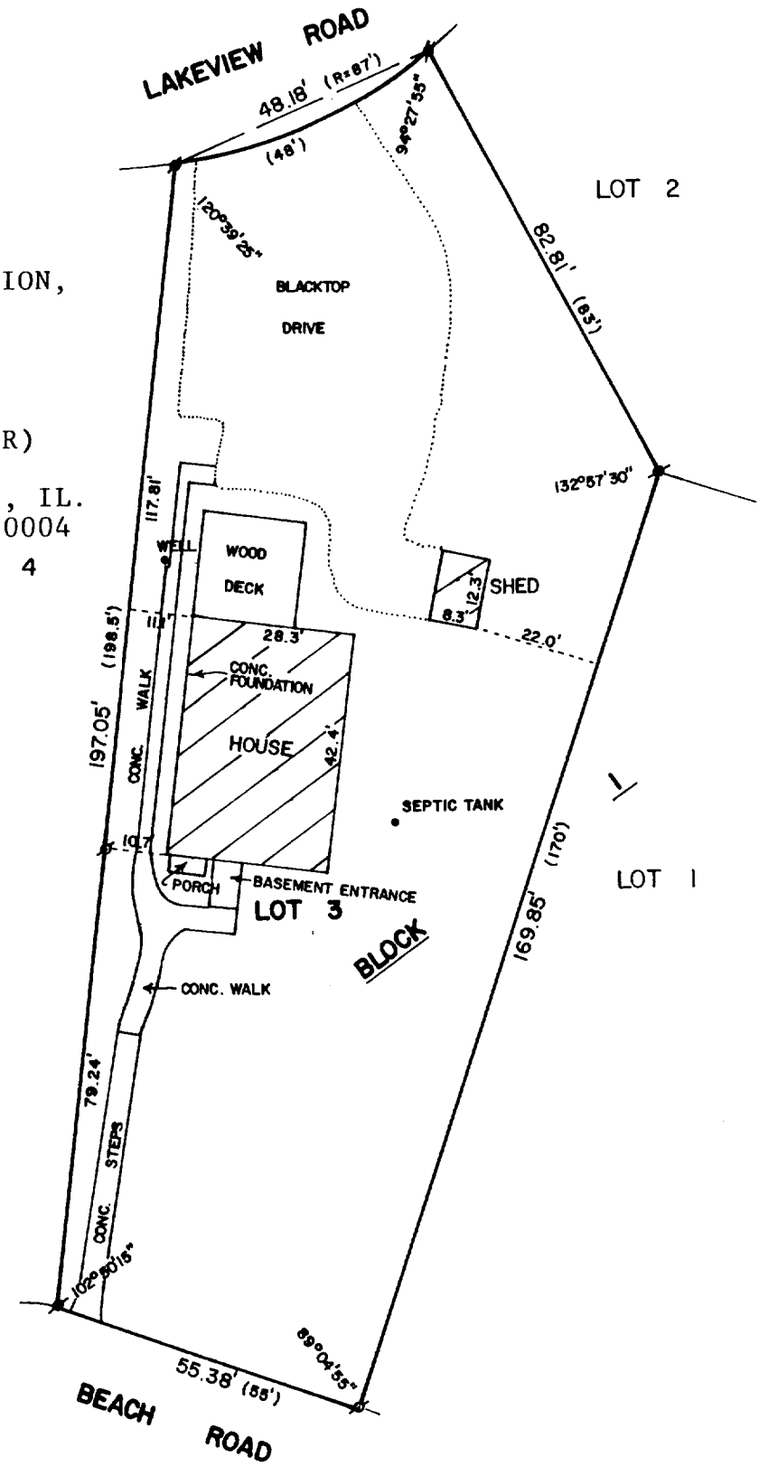

RECEIVED
MAY 26 1989

SCALE - 1"=30'

LEGEND
- ⌀ - IRON PIPE FOUND
- ● - CONCRETE MONUMENT FOUND
- ( )- RECORDED AS

I HEREBY CERTIFY THAT I HAVE SURVEYED THE ABOVE DESCRIBED PROPERTY AND THAT THE ABOVE MAP IS A TRUE REPRESENTATION THEREOF AND SHOWS THE SIZE AND LOCATION OF THE PROPERTY, ITS EXTERIOR BOUNDARIES, THE LOCATION OF ALL VISIBLE STRUCTURES AND DIMENSIONS OF ALL PRINCIPAL BUILDINGS THEREON, BOUNDARY FENCES, APPARENT EASEMENTS, ROADWAYS AND VISIBLE ENCROACHMENTS, IF ANY, TO THE BEST OF MY KNOWNLEDGE AND BELIEF.
THIS SURVEY IS MADE FOR THE USE OF THE PRESENT OWNERS OF THE PROPERTY, AND ALSO THOSE WHO PURCHASE, MORTGAGE, OR GUARANTEE THE TITLE THERETO WITHIN ONE (1) YEAR FROM THE DATE HEREOF.

David F. Abell
DAVID F. ABELL
WISCONSIN REGISTERED LAND SURVEYOR, S-1596

April 10, 1989 REVISED: APRIL 14, 1989
DATE JOB NUMBER - 89043

NOTE: THIS IS NOT A CERTIFIED COPY UNLESS SEALED.

IW-3

117-966