


WALWORTH COUNTY
SURVEYING & MAPPING
LAKE GENEVA, WISCONSIN

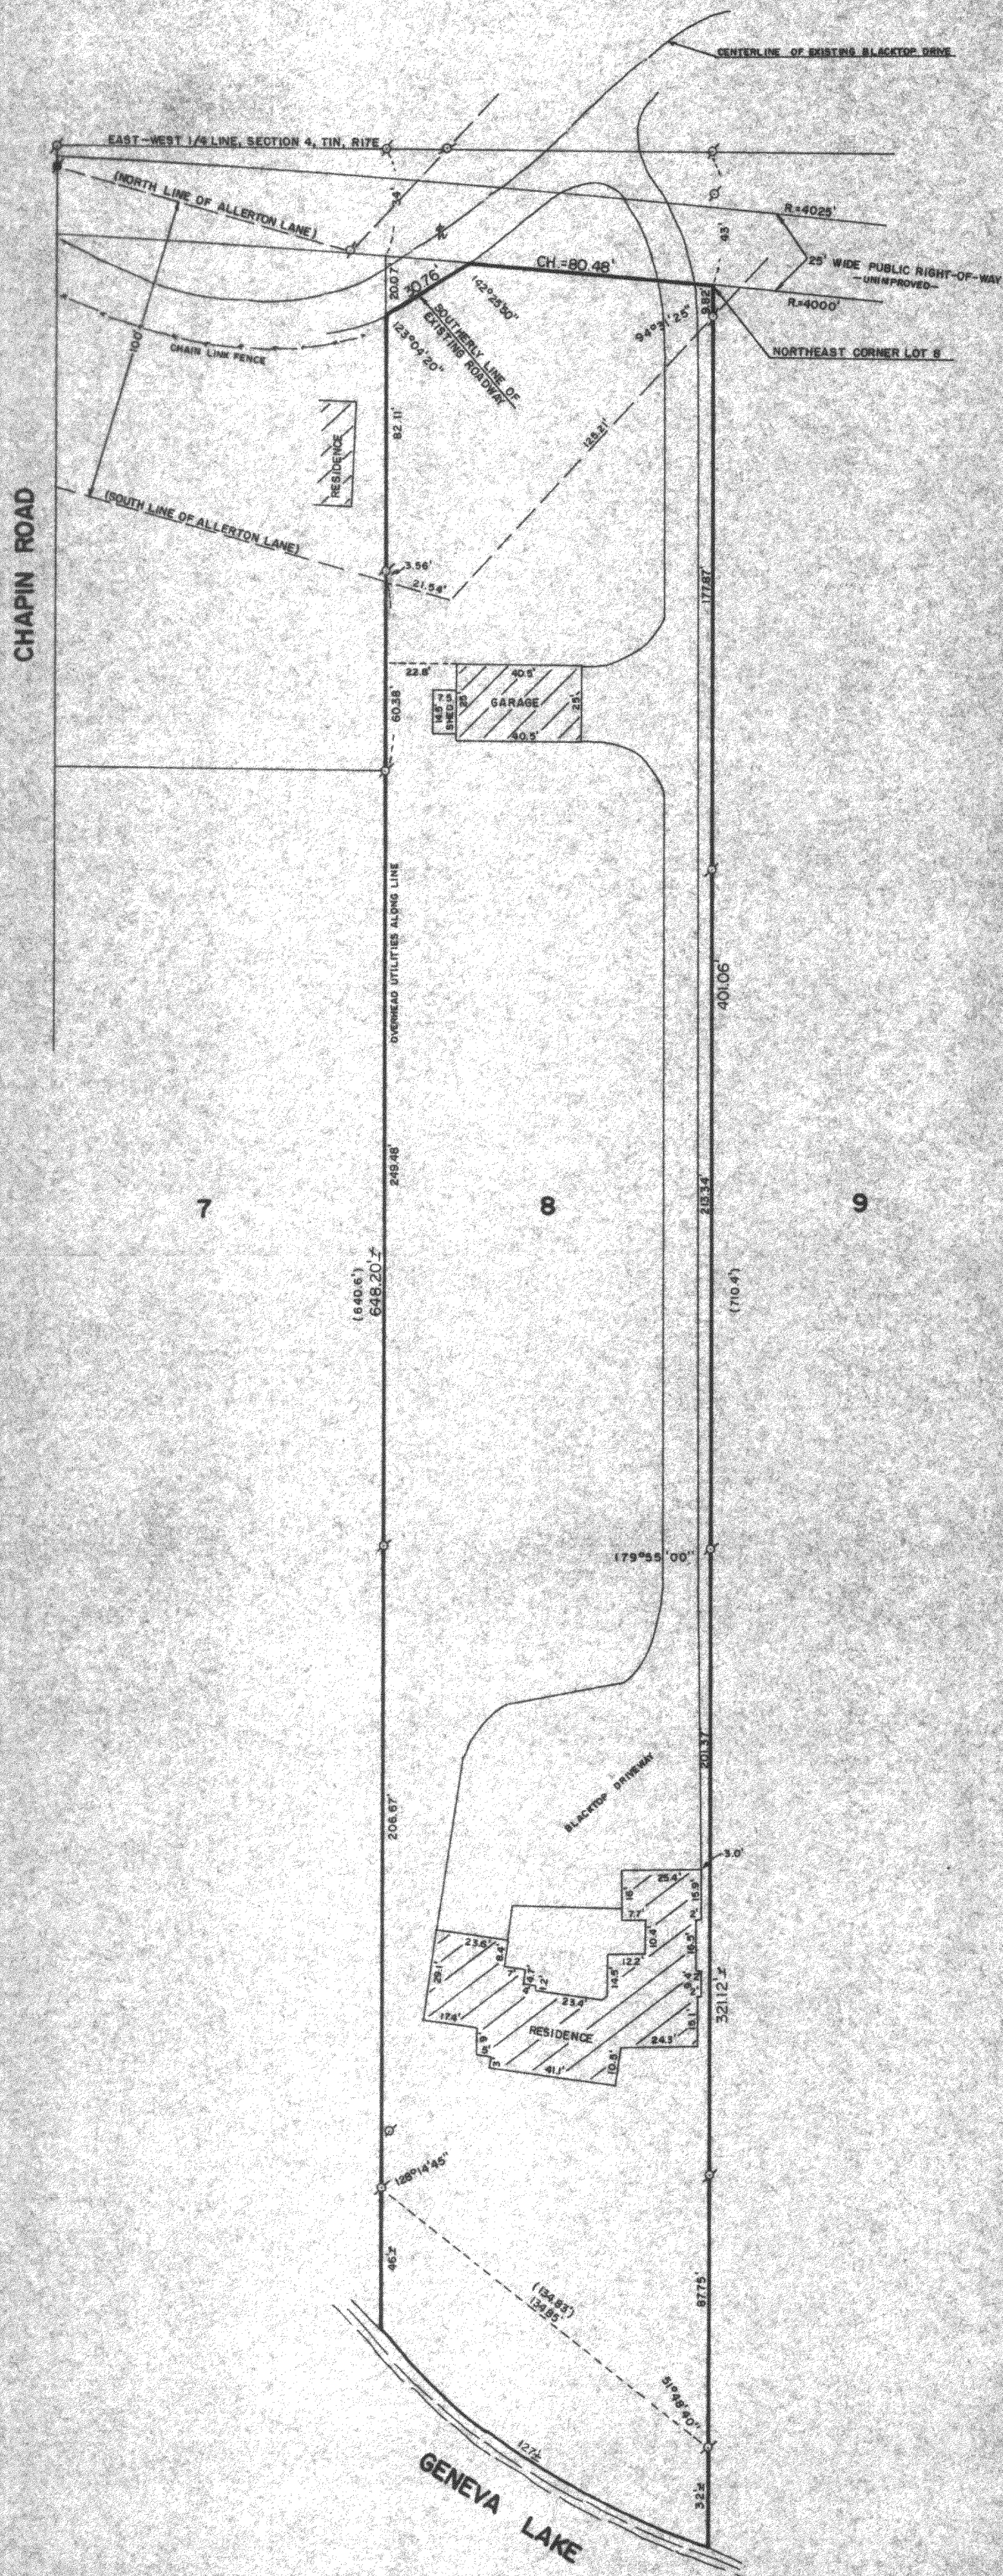

PLAT OF SURVEY OF

LOT NUMBER EIGHT (8) IN S. B. CHAPIN'S SUBDIVISION OF A PART OF THE SOUTH ONE-HALF (1/2) OF FRACTIONAL SECTION NUMBER FOUR (4) IN TOWN ONE (1) NORTH, RANGE SEVENTEEN (17) EAST ACCORDING TO THE PLAT OF SAID SUBDIVISION OF RECORD IN THE OFFICE OF THE REGISTER OF DEEDS IN AND FOR THE COUNTY OF WALWORTH AND STATE OF WISCONSIN, IN VOLUME NUMBER 7 OF PLATS AT PAGE 60.


EXCEPTING AND RESERVING THEREFROM, ALL THAT PART OF SAID LOT NUMBER EIGHT (8) LYING NORTH AND NORTHERLY OF THE SOUTH AND SOUTHERLY LINE OF A CERTAIN ROADWAY AS NOW IMPROVED, OPEN AND TRAVELED ALONG AND UPON A PORTION OF THE NORTH END OF SAID LOT NUMBER EIGHT (8).

NOTE: A DEED DATED NOV. 9, 1983, RECORDED IN VOLUME 312 ON PAGE 948 AS DOCUMENT NUMBER 95488, TRANSFERRED THE AREA DENOTED AS "ALLERTON LANE" FROM THE CHAPIN ESTATE TO BELL. IN 1942, CHAPIN DEEDED LOT 8 USING THE ABOVE DESCRIPTION TO HARRING. ALLERTON LANE WAS FIRST SHOWN ON THE UNRECORDED PLAT OF BROOKDALE ESTATES, DATED JULY 1, 1940, A COPY OF WHICH IS ON FILE AT THE WALWORTH COUNTY SURVEYOR'S OFFICE IN EKHORN, WISCONSIN.

ORDERED BY: KEEFE REAL ESTATE
704 MAIN STREET
LAKE GENEVA, WISCONSIN
53147


NOTE: EXISTING LINE OF OCCUPATION IS THE SOUTHERLY EDGE OF THE EXISTING ROAD PAVEMENT.

NOTE: FENCE LOCATED ALONG THE RESIDENCE IS ON LOT 9.

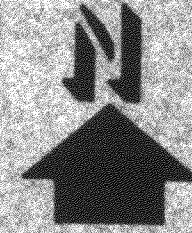

SCALE: 1"=40'

⊕-IRON PIPE FOUND
()-RECORDED AS

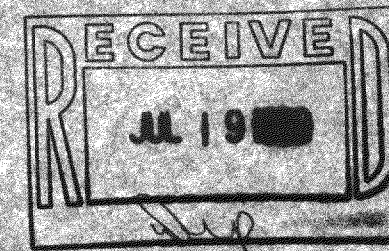

I HEREBY CERTIFY THAT I HAVE SURVEYED THE ABOVE DESCRIBED PROPERTY AND THAT THE ABOVE MAP IS A TRUE REPRESENTATION THEREOF AND SHOWS THE SIZE AND LOCATION OF THE PROPERTY, ITS EXTERIOR BOUNDARIES, THE LOCATION OF ALL VISIBLE STRUCTURES AND DIMENSIONS OF ALL PRINCIPAL BUILDINGS THEREON, BOUNDARY FENCES, APPARENT EASEMENTS, ROADWAYS AND VISIBLE ENCROACHMENTS, IF ANY.

THIS SURVEY IS MADE FOR THE USE OF THE PRESENT OWNERS OF THE PROPERTY AND ALSO THOSE WHO PURCHASE, MORTGAGE OR GUARANTEE THE TITLE THEREIN WITHIN ONE (1) YEAR FROM DATE HEREOF.

Robert M. Baerenwald
ROBERT M. BAERENWALD
WISCONSIN REGISTERED LAND SURVEYOR, S-1508

DATE *April 27, 1989*
JOB NO. 1947

