PLAT OF SURVEY
OF

LOTS 5,6,7 & 8, IN BLOCK 3 OF ROSE NIPPERSINK GARDENS, A SUBDIVISION LOCATED IN THE SOUTHEAST 1/4 OF SECTION 24, T. 1 N., R. 18 E. OF THE 4TH P.M., TOWNSHIP OF BLOOMFIELD, COUNTY OF WALWORTH, STATE OF WISCONSIN.

FOR: RUDICH SCALE 1" = 50'


BEARINGS RELATE TO RECORDED PLAT DATUM

o = IRON PIPE STAKE SET.

ø = IRON PIPE STAKE FOUND

● = CONCRETE MONUMENT FOUND.

RECEIVED
JUL 8 1992
dg

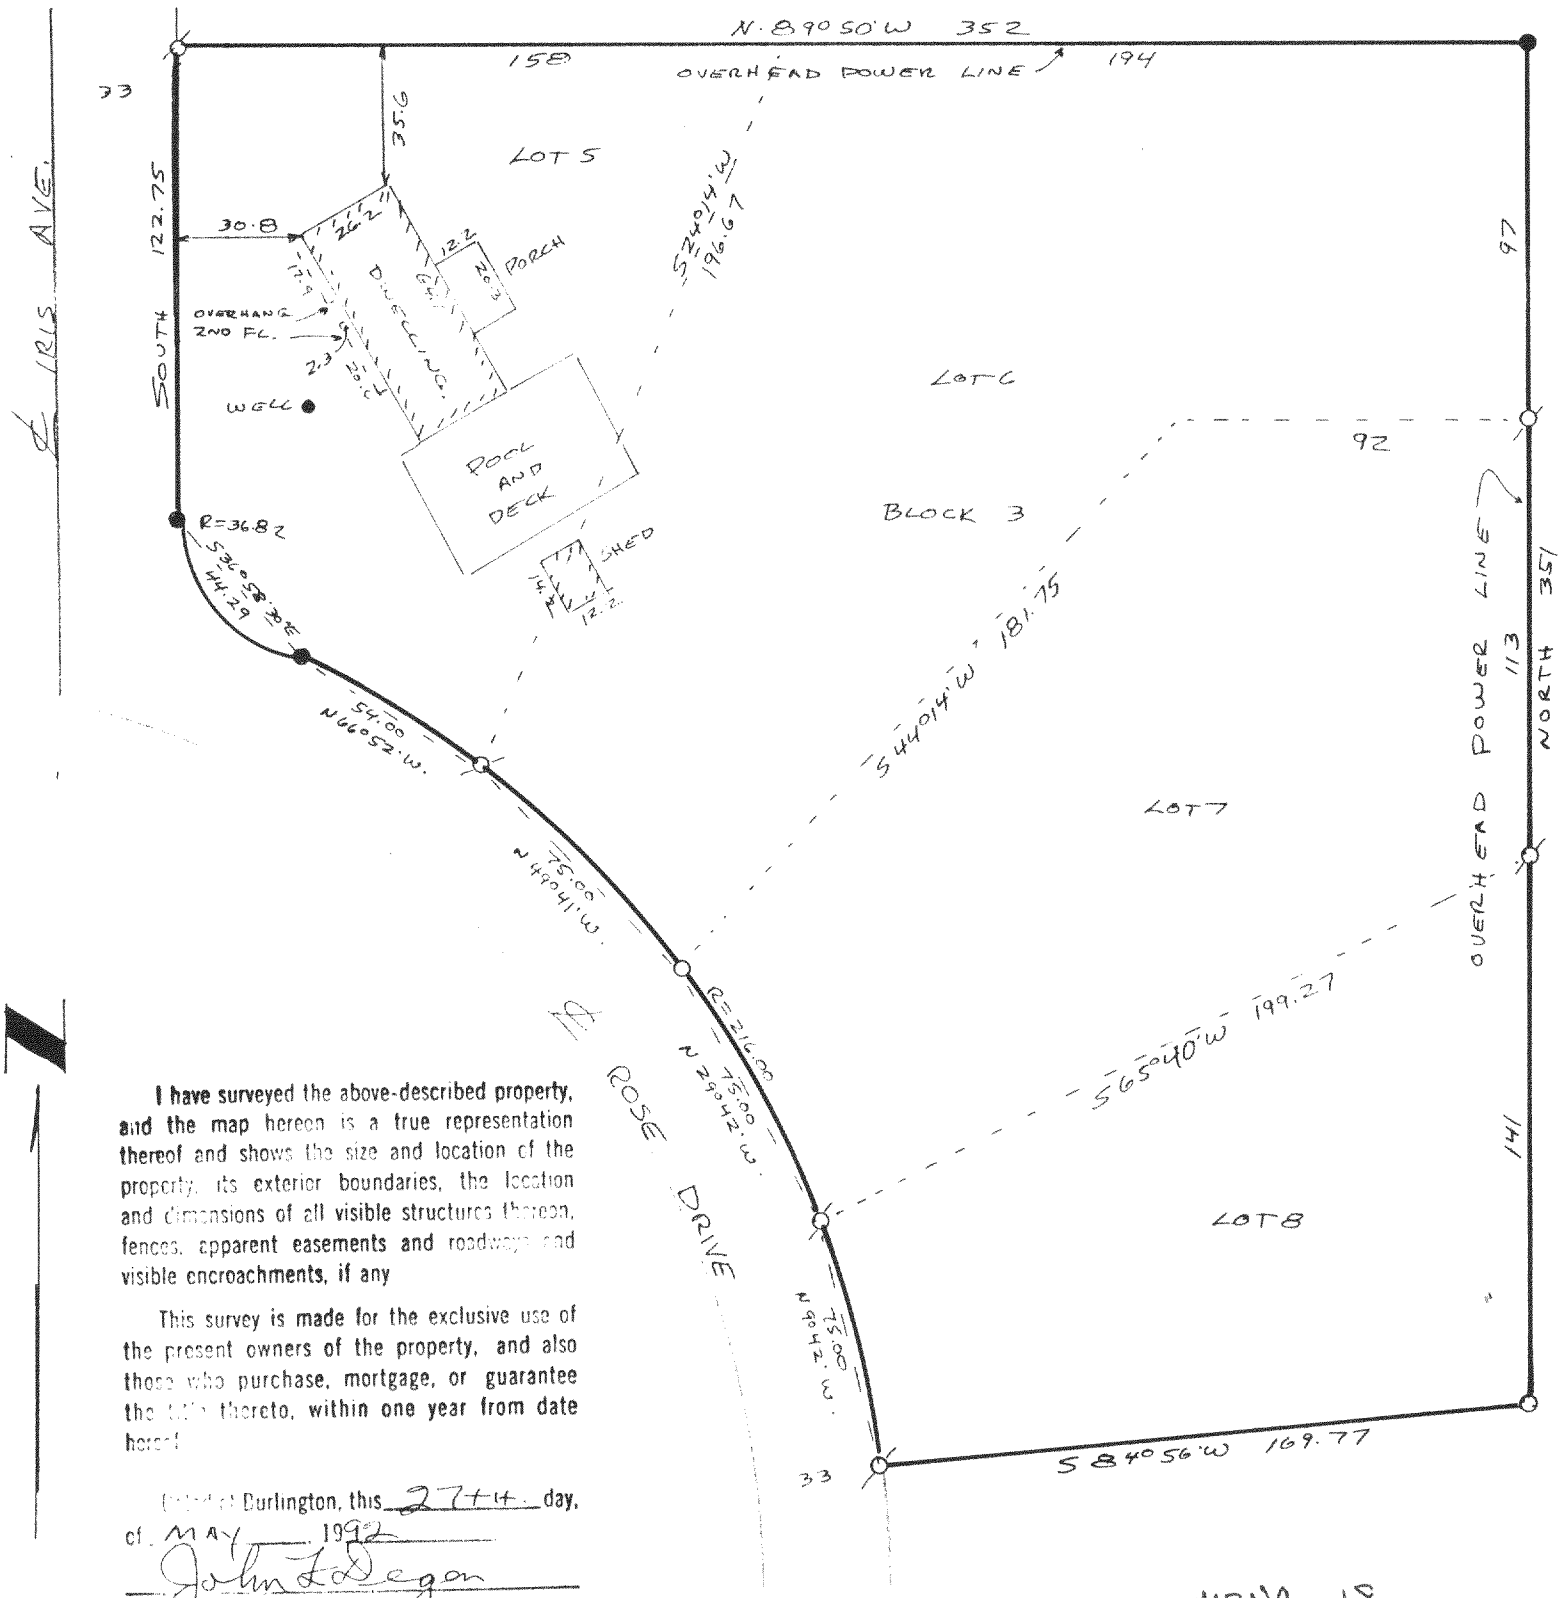

I have surveyed the above-described property, and the map hereon is a true representation thereof and shows the size and location of the property, its exterior boundaries, the location and dimensions of all visible structures thereon, fences, apparent easements and roadways and visible encroachments, if any

This survey is made for the exclusive use of the present owners of the property, and also those who purchase, mortgage, or guarantee the title thereto, within one year from date hereof.

Dated at Burlington, this 27th day, of MAY 1992

John F. Degen

John F. Degen, Land Surveyor S 242
589 N. Pine St. Burlington, WI 53105

MRNG - 18
MRNG - 19
MRNG - 19A
MRNG - 20

118-1067