KOLB LAND CONSULTING, INC.

LAND SURVEYING · SUBDIVIDING · LAND PLANNING

929 WILLIAMS STREET LAKE GENEVA, WISCONSIN 53147 414-248-3697

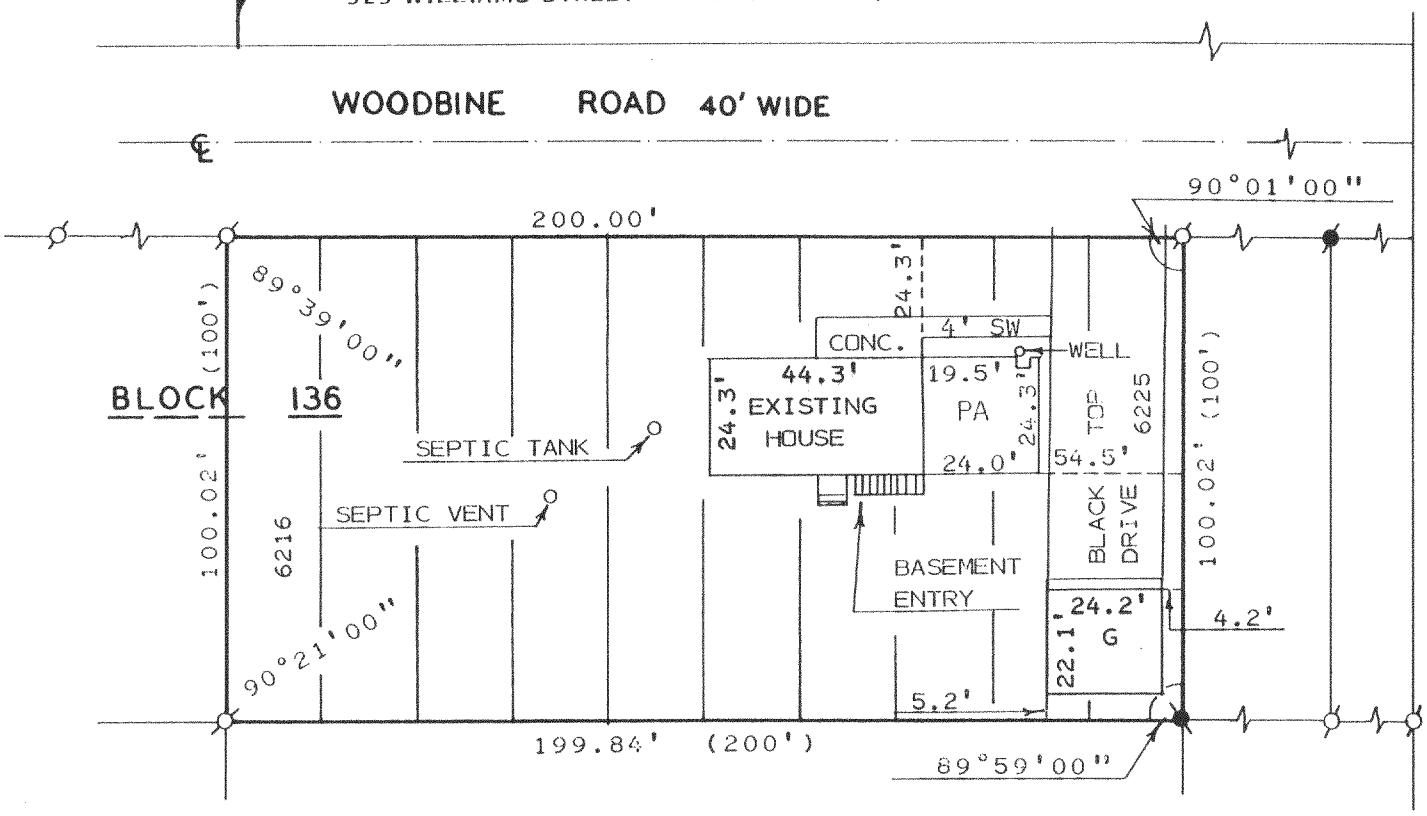

PLAT OF SURVEY OF

LOTS 6216-6225, BLOCK 136 OF PELL LAKE SUBDIVISION LOCATED IN T1N, R18E, TOWN OF BLOOMFIELD, WALWORTH COUNTY, WISCONSIN.

ORDERED BY: GLENN HERRELL
1025 WOODBINE RD. P.O. BOX 127
PELL LAKE, WI. 53157

RECEIVED
MAR 2 5 1993
dg

N

SCALE: 1" = 40'

LEGEND
- ∅ – IRON PIPE FOUND
- ● – IRON ROD FOUND
- O – IRON PIPE SET
- SW – SIDEWALK
- PA – PROPOSED ADDITION
- ( ) – AS RECORDED

MPL-1353

I, HAROLD H. KOLB, DO HEREBY CERTIFY THAT I HAVE SURVEYED THE PROPERTY HEREON DESCRIBED ACCORDING TO THE OFFICIAL RECORDS, AND THAT THE PLAT HEREON IS A CORRECT REPRESENTATION OF THE LOT LINES TO THE BEST OF MY KNOWLEDGE AND BELIEF. THIS SURVEY IS NOT VALID UNLESS THE SURVEYOR'S SIGNATURE IS IN RED.

HAROLD H. KOLB

WISCONSIN REGISTERED LAND SURVEYOR, S-187

DATE

REVISED

REVISED

1-18-310

118-1181