
# KOLB LAND CONSULTING, INC.

LAND SURVEYING · SUBDIVIDING · LAND PLANNING

929 WILLIAMS STREET LAKE GENEVA, WISCONSIN 53147 414-248-3697

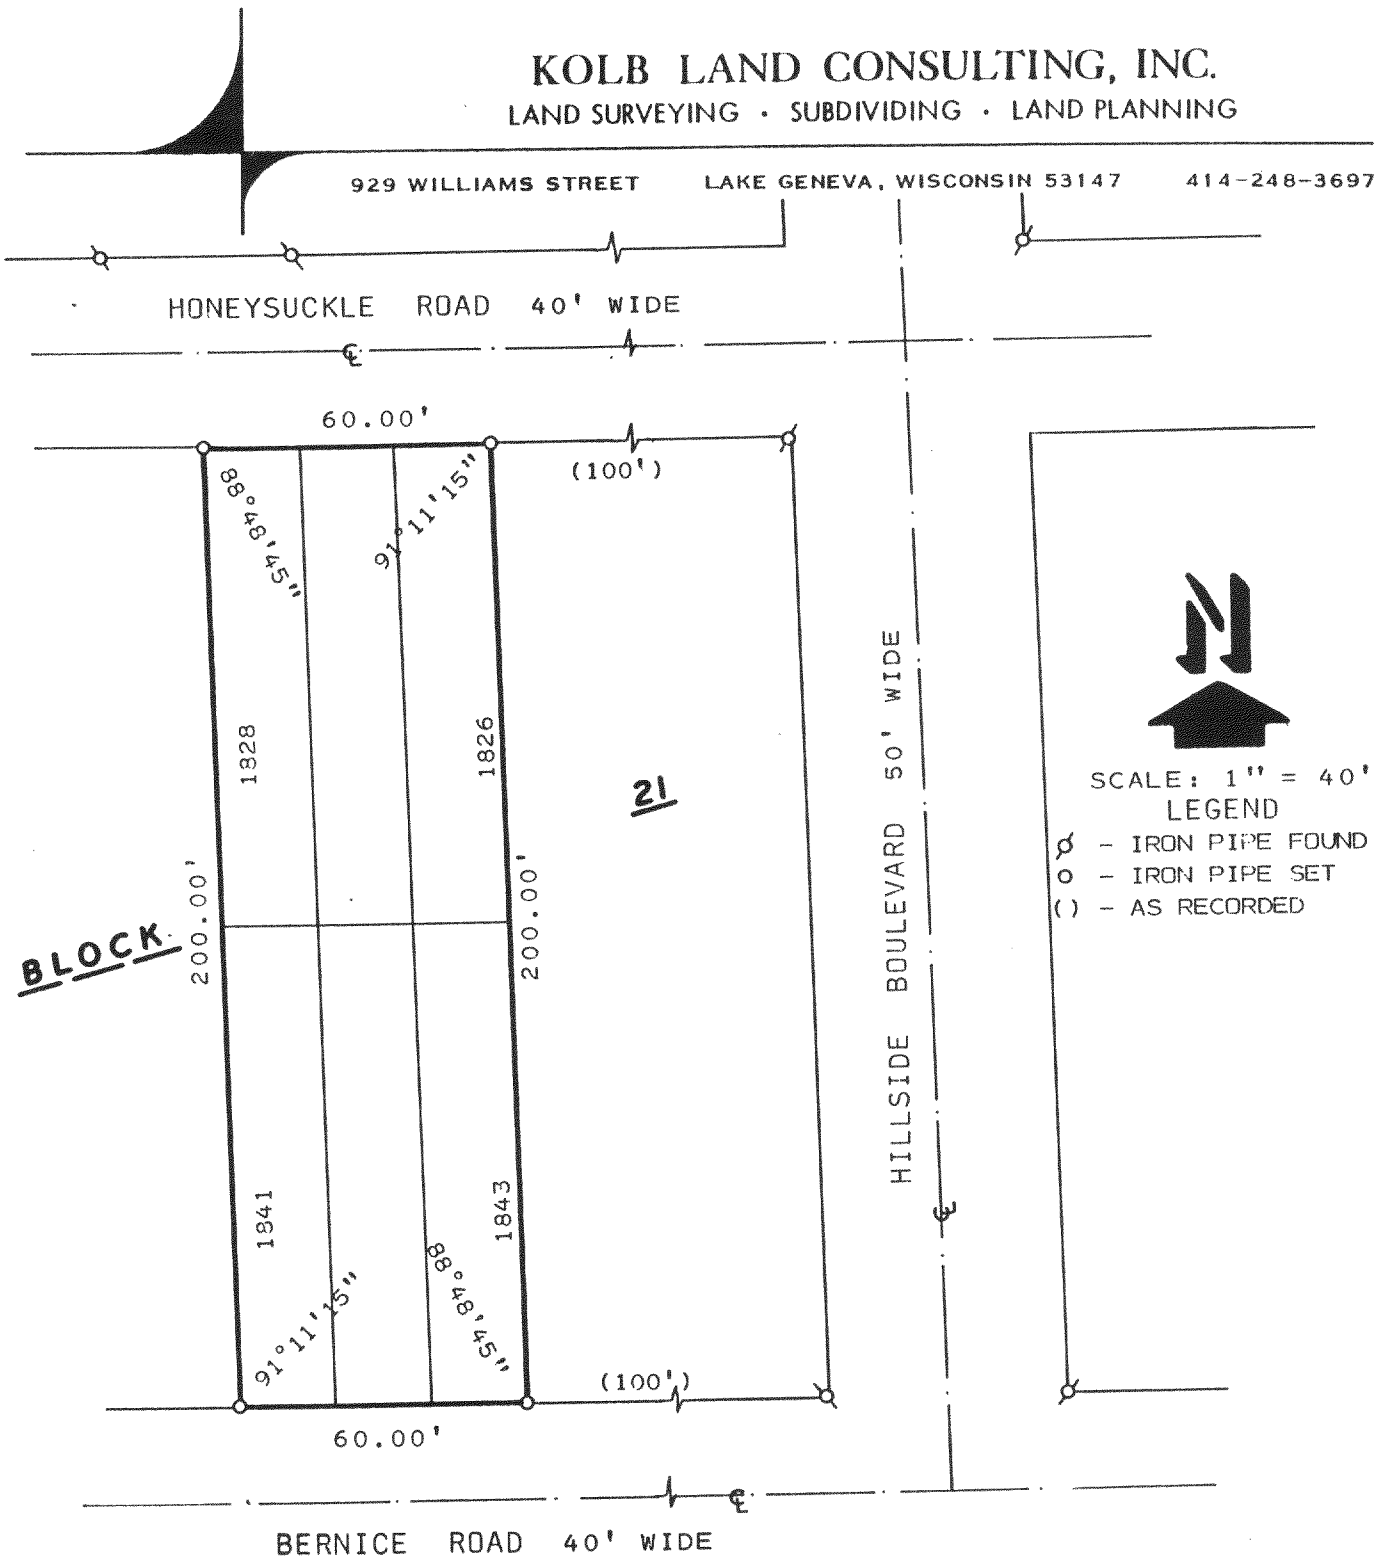


SCALE: 1" = 40'

LEGEND

- ⌀ – IRON PIPE FOUND
- o – IRON PIPE SET
- ( ) – AS RECORDED

PLAT OF SURVEY OF

ORDERED BY: JOHN ARNOW
35033 INDIAN TRAIL RD.
INGLESIDE, IL. 60041

LOTS 1826-1828 AND 1841-1843, BLOCK 21 OF PELL LAKE HIGHLANDS, A SUBDIVISION LOCATED IN T1N, R18E, TOWN OF BLOOMFIELD, WALWORTH COUNTY, WISCONSIN.

RECEIVED
JAN 14 1994

I, HAROLD H. KOLB, DO HEREBY CERTIFY THAT I HAVE SURVEYED THE PROPERTY HEREON DESCRIBED ACCORDING TO THE OFFICIAL RECORDS AND THAT THE PLAT HEREON IS A CORRECT REPRESENTATION OF THE LOT LINES TO THE BEST OF MY KNOWLEDGE AND BELIEF.
SURVEY NOT VALID UNLESS SURVEYOR'S SIGNATURE IS IN RED.

HAROLD H. KOLB
WISCONSIN REGISTERED LAND SURVEYOR, S-187
DATE OCTOBER 8, 1993
REVISED
REVISED

MPLH-324

MPLH-327

118-1274

1-18/PLH-406