
HAROLD H. KOLB
REGISTERED PROFESSIONAL LAND SURVEYOR
LAKE GENEVA, WISCONSIN

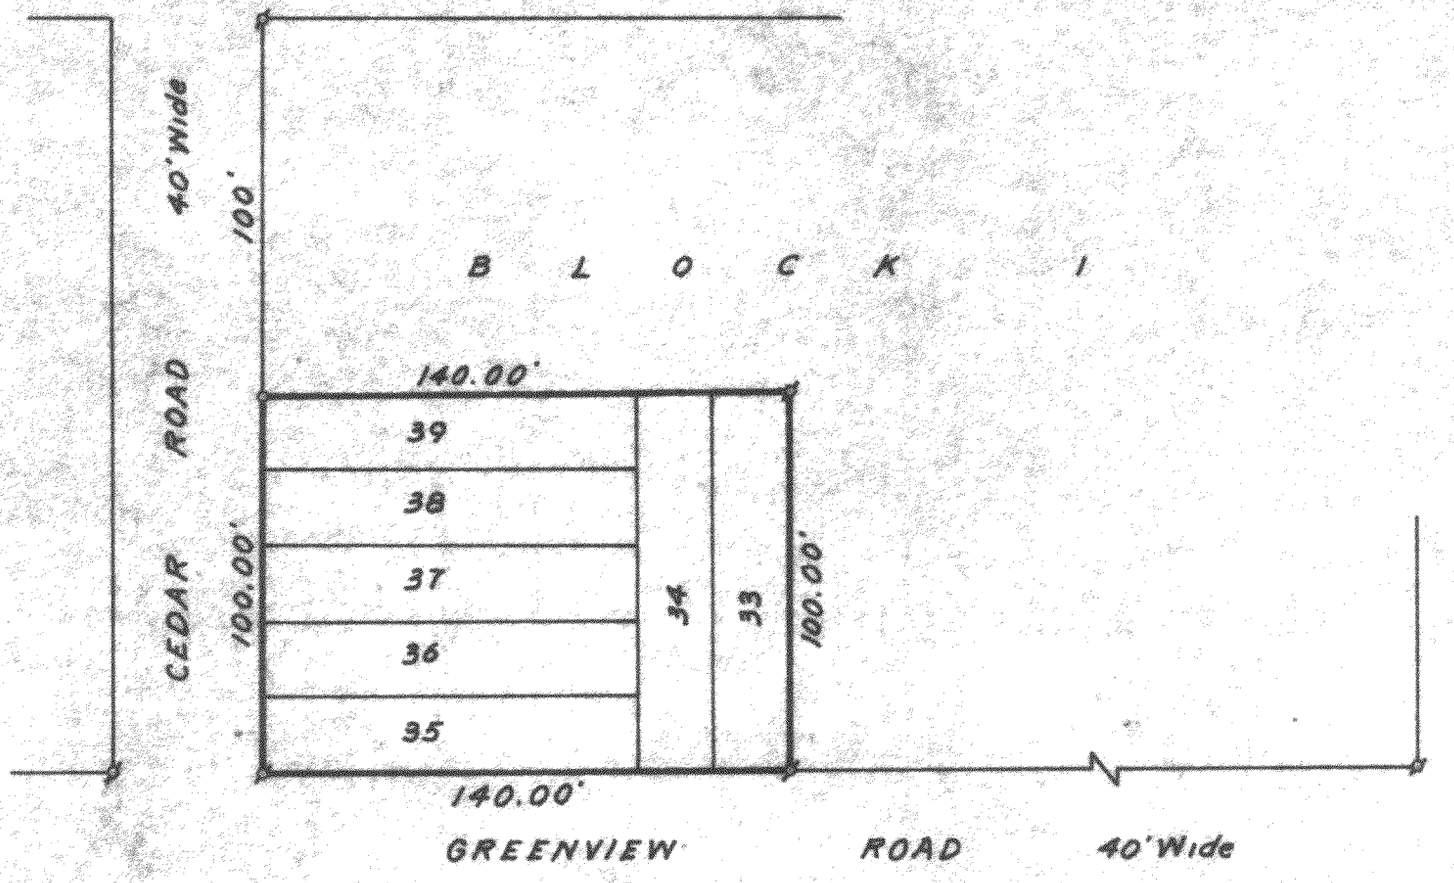

PLAT OF SURVEY OF
Lots 33-39, Block 1, Pell Lake Highlands,
Walworth County, Wisconsin.

Harold H. Kolb
Harold H. Kolb, Wisconsin Surveyor, S-187
DATE: October 8, 1963

WISCONSIN
HAROLD H. KOLB
LAND SURVEYOR
LAKE GENEVA,
S-187
WISCONSIN
REGISTERED

⊠ - Iron Pipe Found
○ - Iron Pipe Placed

118-128