PLAT OF SURVEY
OF

LOTS 9702 THRU 9706 IN BLOCK 215 OF SECTION 7 OF PELL LAKE SUBDIVISION, LOCATED IN THE NORTH-EAST 1/4 OF SECTION 21, T. 1 N., R. 18 E. OF THE 4TH P.M., TOWNSHIP OF BLOOMFIELD, COUNTY OF WALWORTH, STATE OF WISCONSIN.

FOR: KRUMPEN SCALE 1" = 40' ⌀ = IRON PIPE FOUND o = IRON PIPE SET.

RECEIVED
AUG 2 1994
dg

I have surveyed the above-described property, and the map hereon is a true representation thereof and shows the size and location of the property, its exterior boundaries, the location and dimensions of all visible structures thereon, fences, apparent easements and roadways and visible encroachments, if any.

This survey is made for the exclusive use of the present owners of the property, and also those who purchase, mortgage, or guarantee the title thereto, within one year from date hereof.

Dated at Burlington, this 1ST. day, of July, 1994

John F. Degen

John F. Degen, Land Surveyor S 242
589 N. Pine St. Burlington, WI 53105

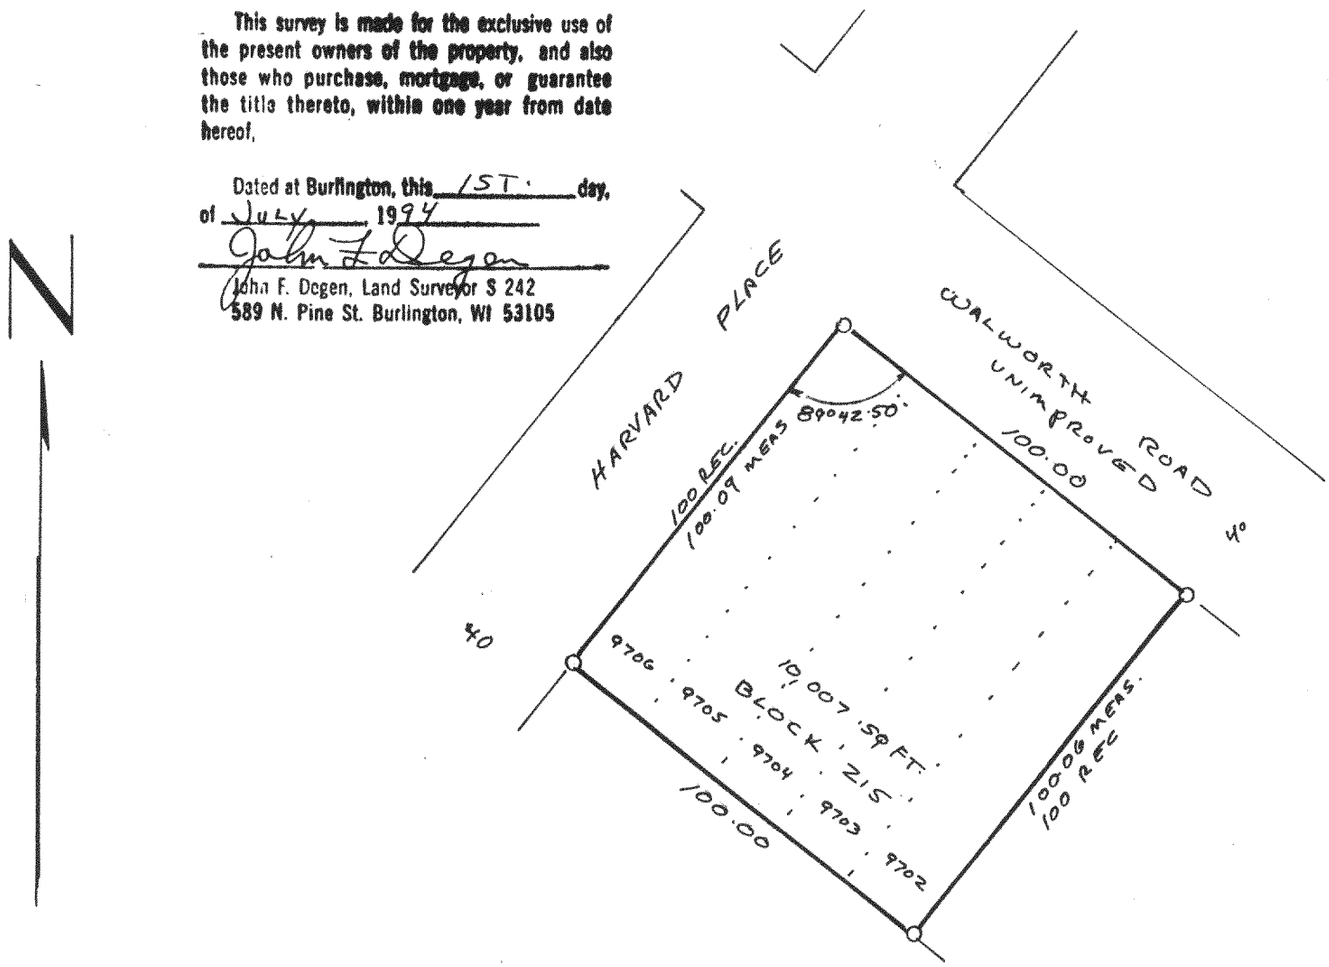

MPL-1963

118-1356 (M) 16-F-3 #31