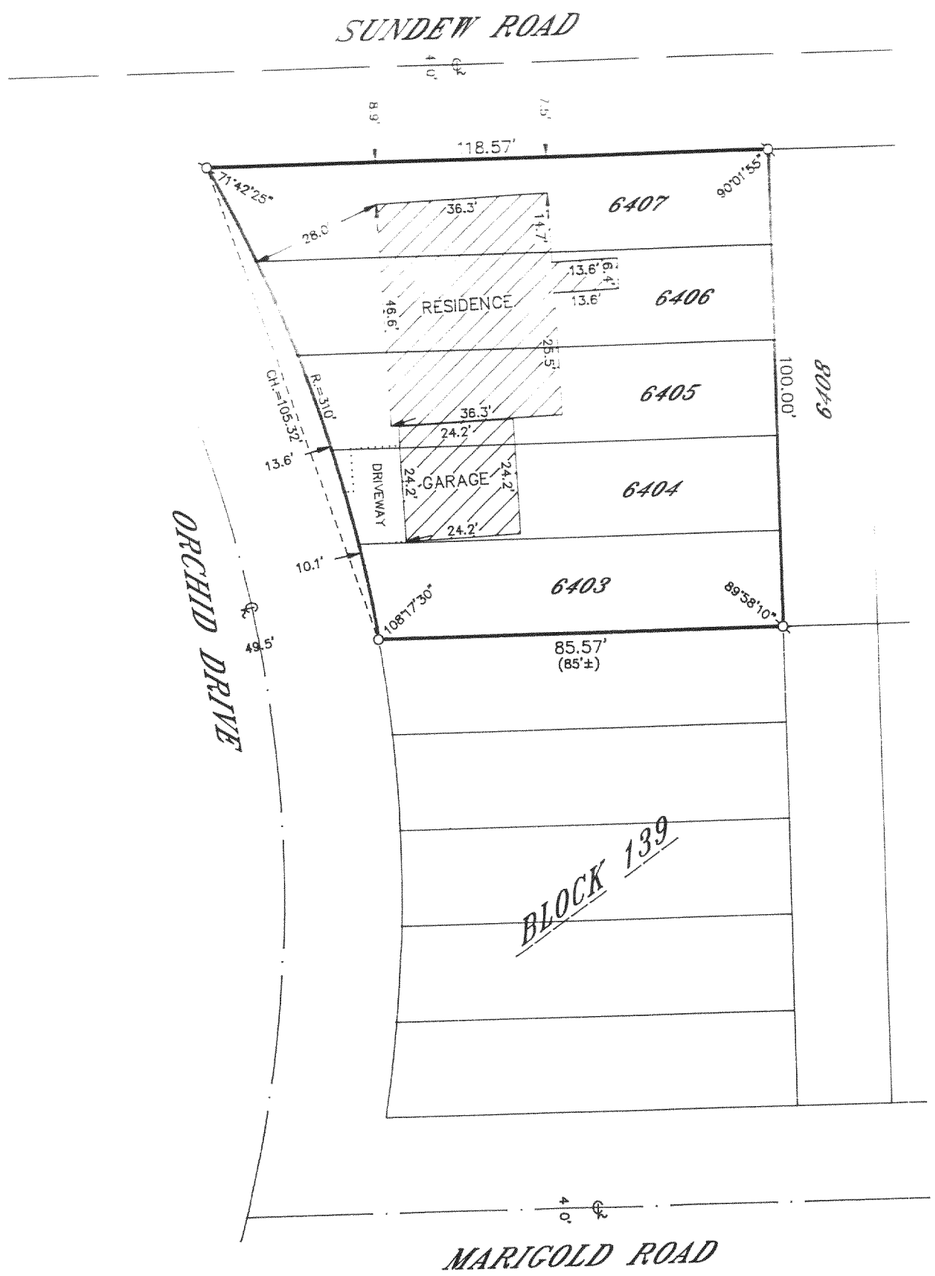

WALWORTH COUNTY
SURVEYING & MAPPING
727 HENRY STREET
LAKE GENEVA, WISCONSIN
414-248-0505

RECEIVED
JAN 13 1995

PLAT OF SURVEY OF

LOTS 6403–6407, BLOCK 139 OF SECTION –
OF PELL LAKE SUBDIVISION, LOCATED IN T
R 18 E, WALWORTH COUNTY, WISCONSIN.

ORDERED BY: PAUL YAKOWENKO
N1758 ORCHID DRIVE
GENOA CITY, WISCONSIN
53128

GRAPHIC SCALE

30 0 15 30 60 120

(IN FEET)

1 inch = 30 ft.

ø–IRON PIPE FOUND
Ø–IRON ROD FOUND
●–CONCRETE MONUMENT FOUND
o–IRON PIPE PLACED
()–RECORDED AS

ASSUMED

I HEREBY CERTIFY THAT I HAVE SURVEYED THE ABOVE DESCRIBED PROPERTY AND THAT THE ABOVE MAP IS A TRUE REPRESENTATION THEREOF AND SHOWS THE SIZE AND LOCATION OF THE PROPERTY, ITS EXTERIOR BOUNDARIES, THE LOCATION OF ALL VISIBLE STRUCTURES AND DIMENSIONS OF ALL PRINCIPAL BUILDINGS THEREON, BOUNDARY FENCES, APPARENT EASEMENTS, ROADWAYS AND VISIBLE ENCROACHMENTS, IF ANY, TO THE BEST OF MY KNOWLEDGE AND BELIEF.

THIS SURVEY IS MADE FOR THE USE OF THE PRESENT OWNERS OF THE PROPERTY AND ALSO THOSE WHO PURCHASE, MORTGAGE OR GUARANTEE THE TITLE THERETO WITHIN ONE (1) YEAR FROM DATE HEREOF.

Robert M. Baerenwald

ROBERT M. BAERENWALD
WISCONSIN REGISTERED LAND SURVEYOR, S-1508

DATE July 12, 1994 JOB NO. 4304

NOTE: THIS IS NOT A CERTIFIED COPY UNLESS SEALED.

MPL-1401

118-1391