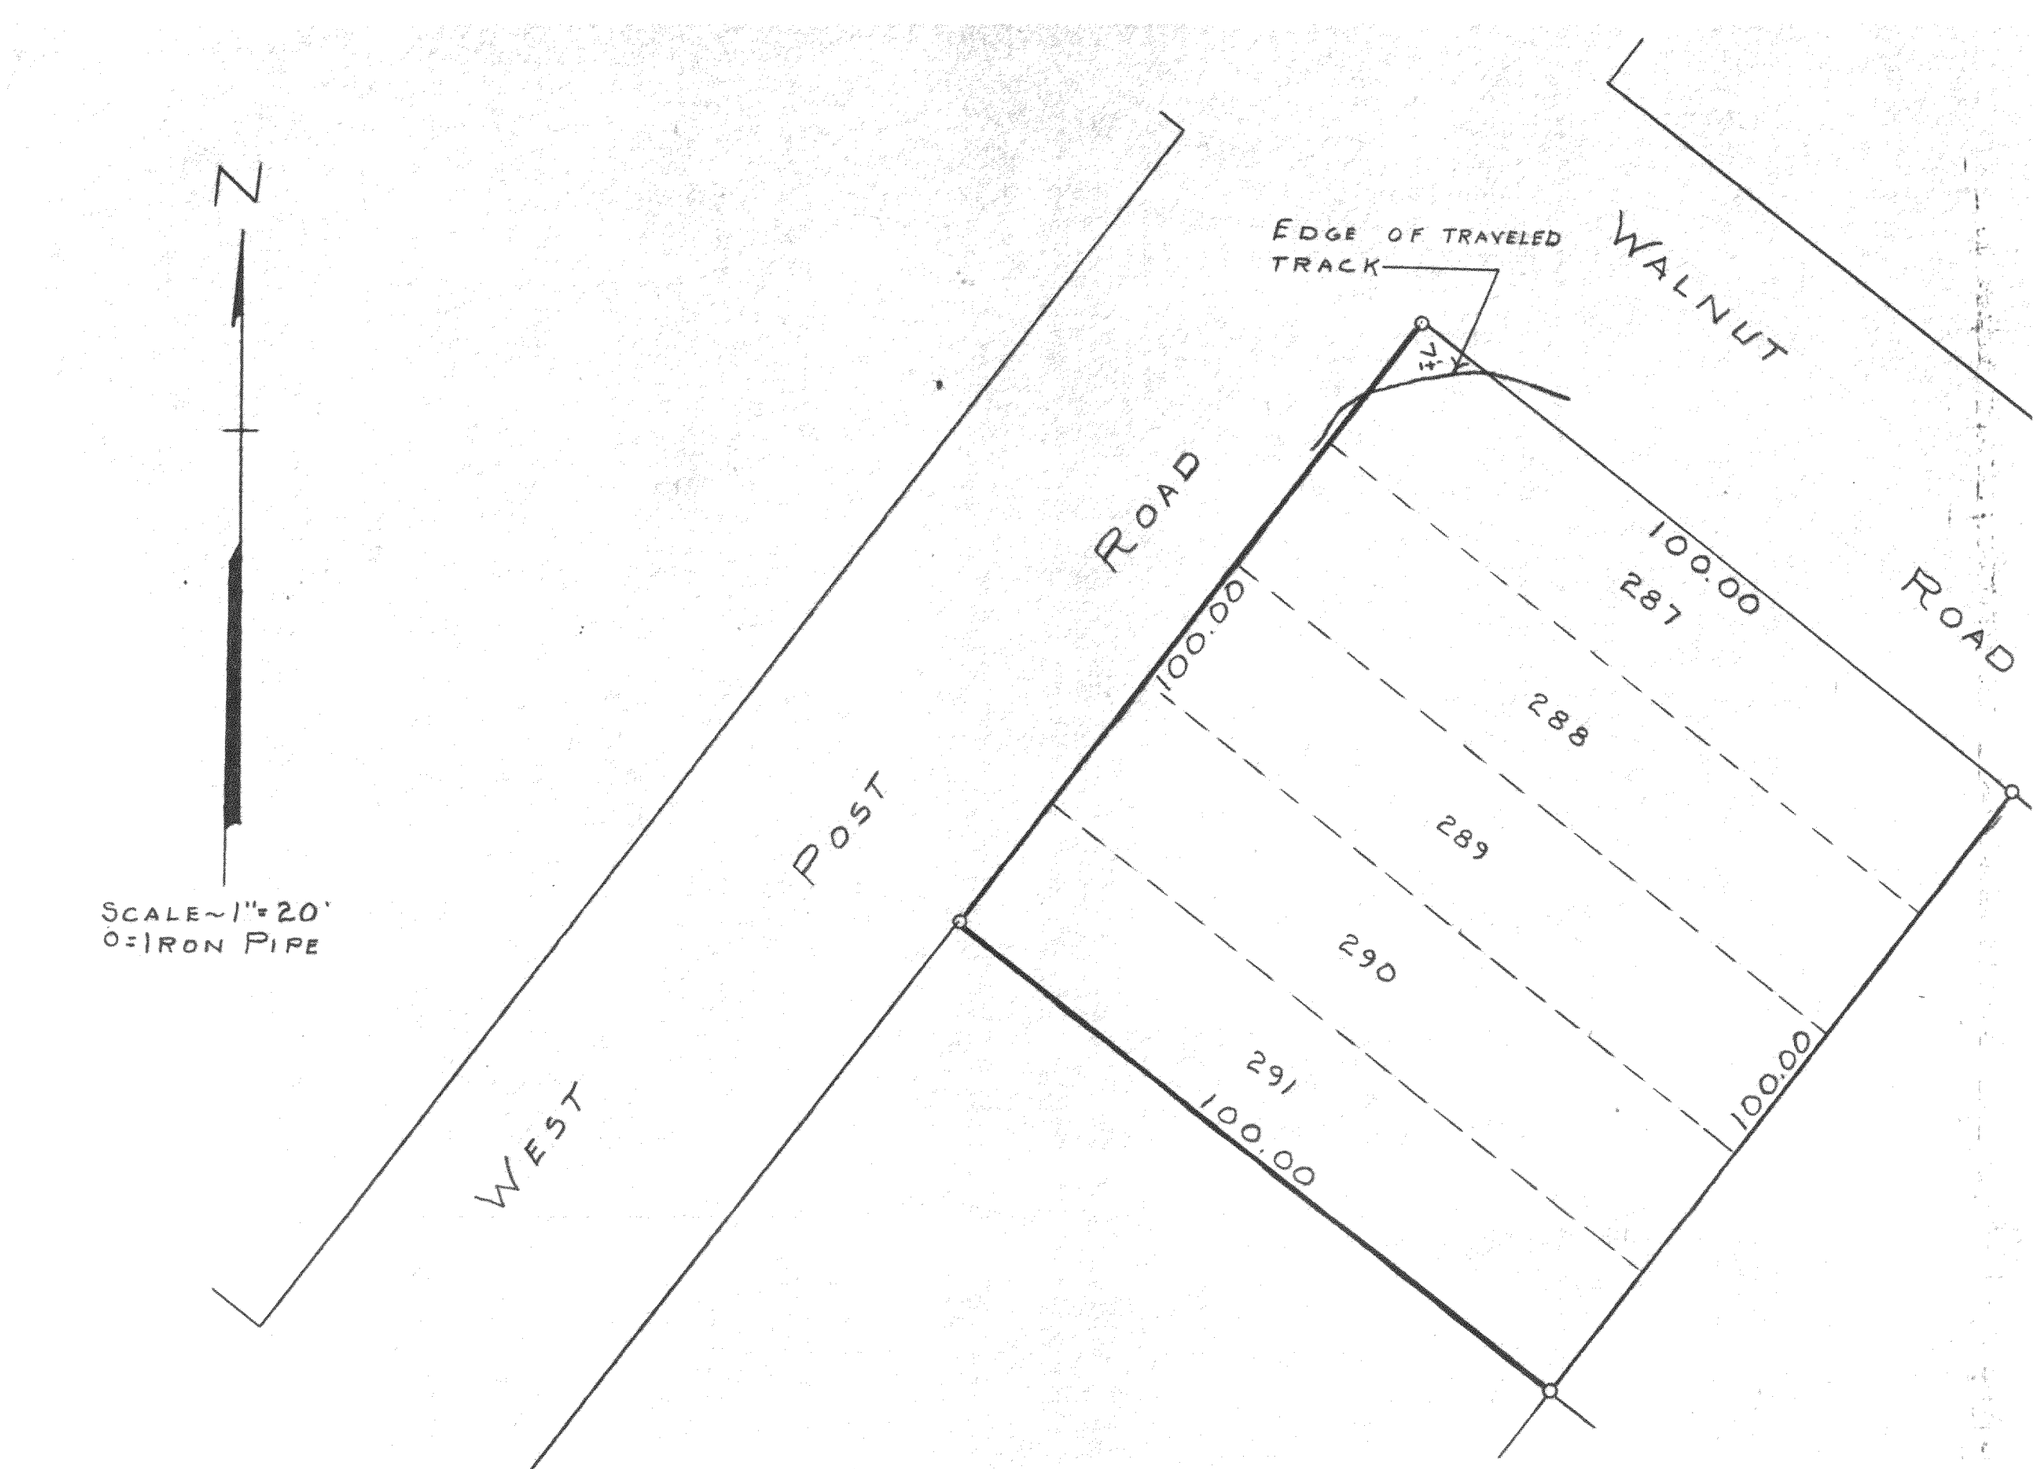


PLAT OF SURVEY OF LOTS 287-291 INCLUSIVE, SECTION 1 OF PELL LAKE LOCATED IN SECTION 21, T1NR18E OF WALWORTH COUNTY WISCONSIN
SEPT. 16, 1955

George T. Dunham
GEORGE T. DUNHAM, SURVEYOR
DELAVAN, WISCONSIN

118-14