DUNHAM SURVEYING, S. C.
SURVEYING & SUBDIVIDING
DELAVAN, WISCONSIN 53115

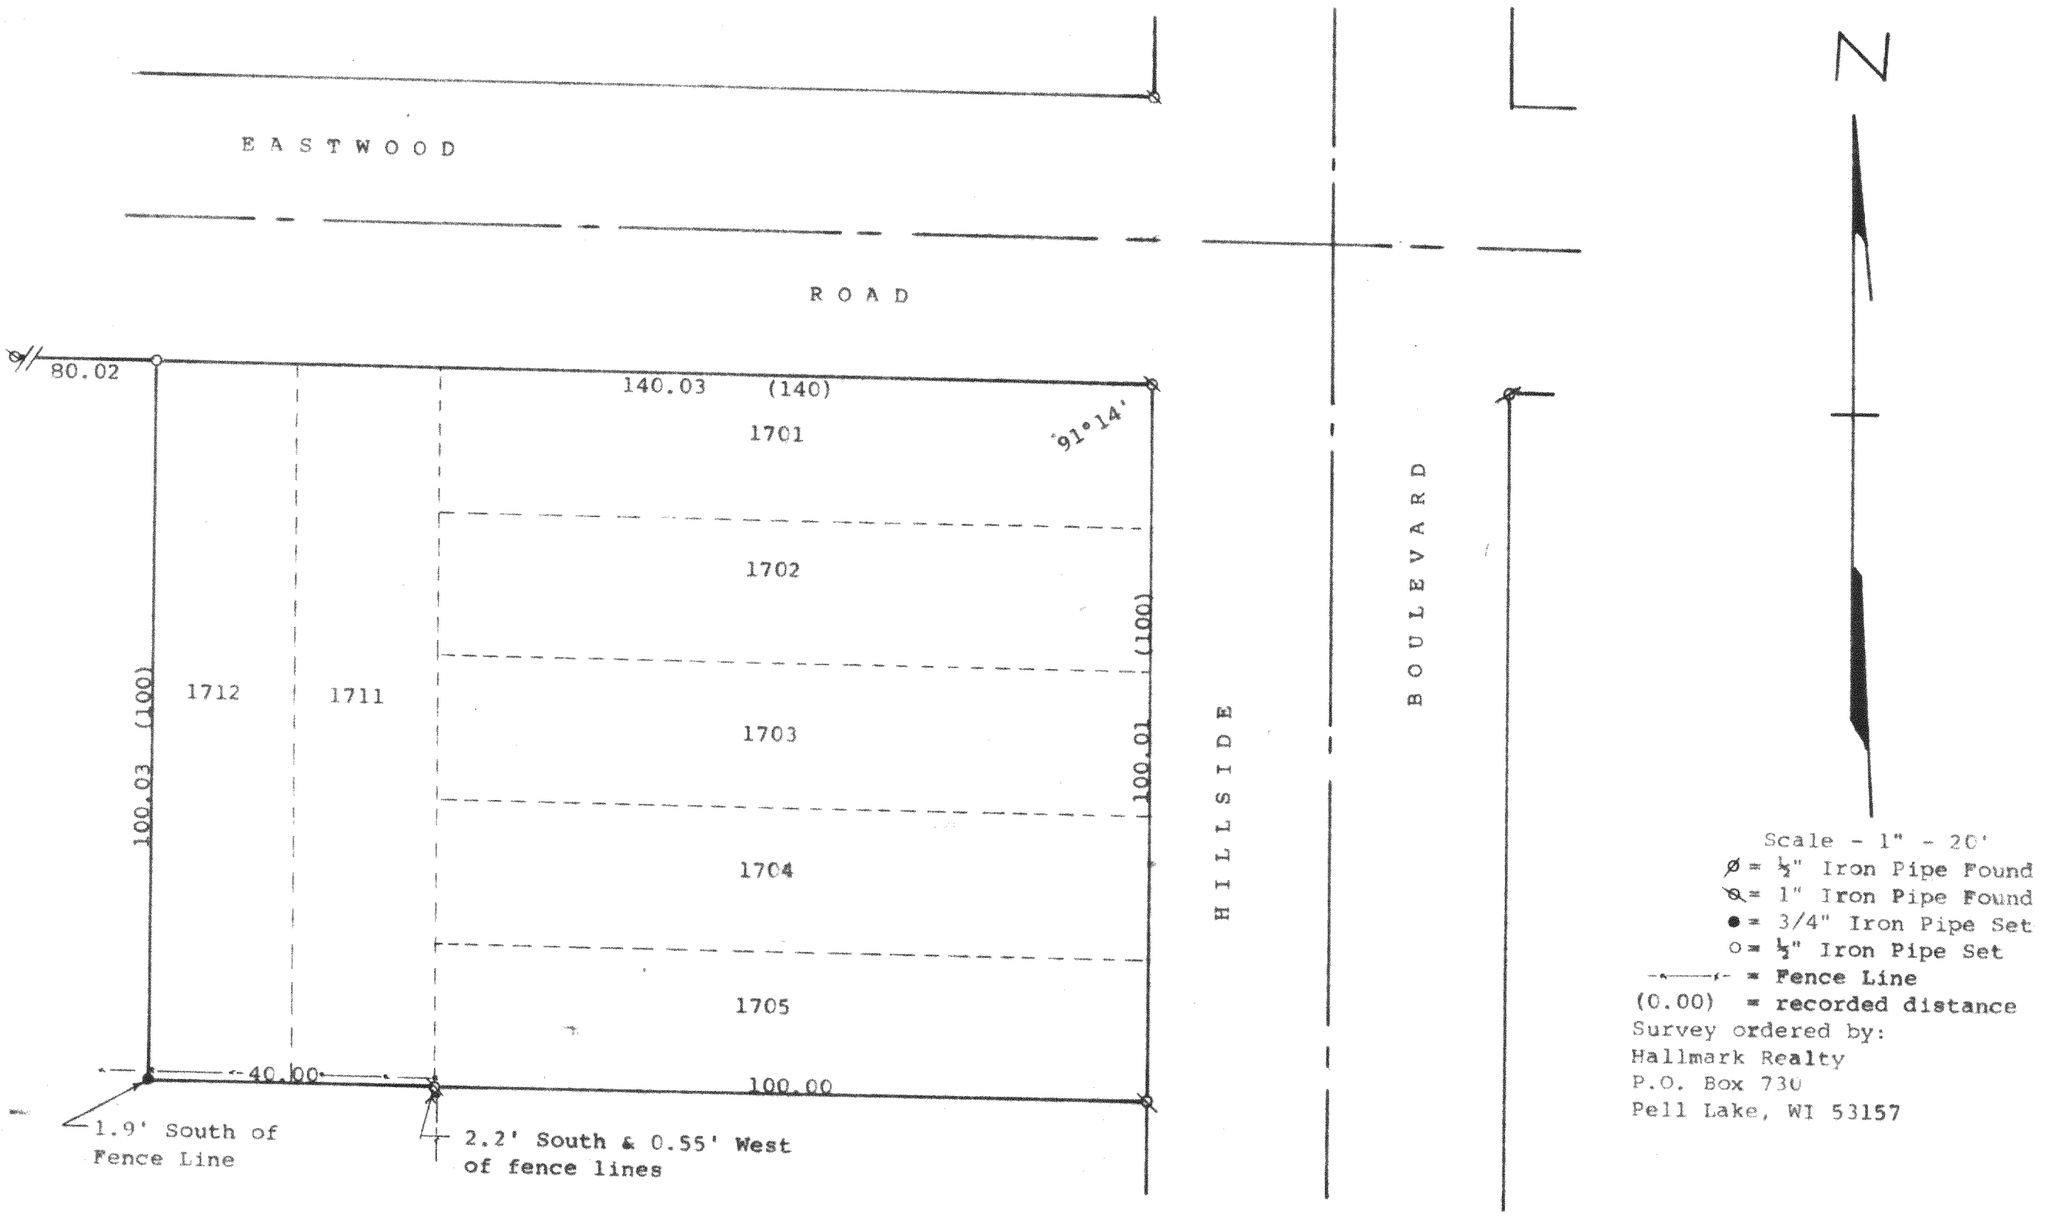

STATE OF WISCONSIN)
COUNTY OF WALWORTH) SS

I, George T. Dunham, Surveyor, certify that I have surveyed the property described as follows:

Lots 1701-1705 inclusive and Lots 1711 and 1712, all in Block 23 of Pell Lake Highlands, a subdivision located in Section 16, T 1 N, R 18 E, Walworth County, Wisconsin

and that the plat shown hereon is a correct representation thereof and shows the size and location of the property, its exterior boundaries, the location of all visible structures and dimensions of all principal buildings thereon, boundary fences, apparent easements, roadways and visible encroachments, if any, and that I have surveyed the property hereon described, according to the official records, to the best of my knowledge and belief.

October 26, 1994

George T. Dunham, Surveyor

WISCONSIN LAND SURVEYOR
GEORGE T. DUNHAM
S-306
DELAVAN WIS.

RECEIVED
MAR 24 1995

RECEIVED
MAR 24 1995

545273
GMB 1020

MPLH-298

118-1425