PLAT OF SURVEY
OF

LOTS 9718 THRU 9722 In block 214 OF SECTION 7 OF PELL LAKE SUBDIVISION , LOCATED IN SECTION 21, T. 1 N., R. 18 E. of THE 4TH P.M., TOWNSHIP OF BLOOMFIELD, WALWORTH COUNTY, WISCONSIN.

FOR: MEINEN SCALE 1" = 20' ⌀ = IRON PIPE FOUND o = IRON PIPE SET.

RECEIVED
APR 16 1996

I have surveyed the above-described property, and the map hereon is a true representation thereof and shows the size and location of the property, its exterior boundaries, the location and dimensions of all visible structures thereon, fences, apparent easements and roadways and visible encroachments, if any.

This survey is made for the exclusive use of the present owners of the property, and also those who purchase, mortgage, or guarantee the title thereto, within one year from date hereof.

Dated at Burlington, this 4th day, of April, 1996

John F. Degen

John F. Degen, Land Surveyor S 242
589 N. Pine St. Burlington, WI 53105

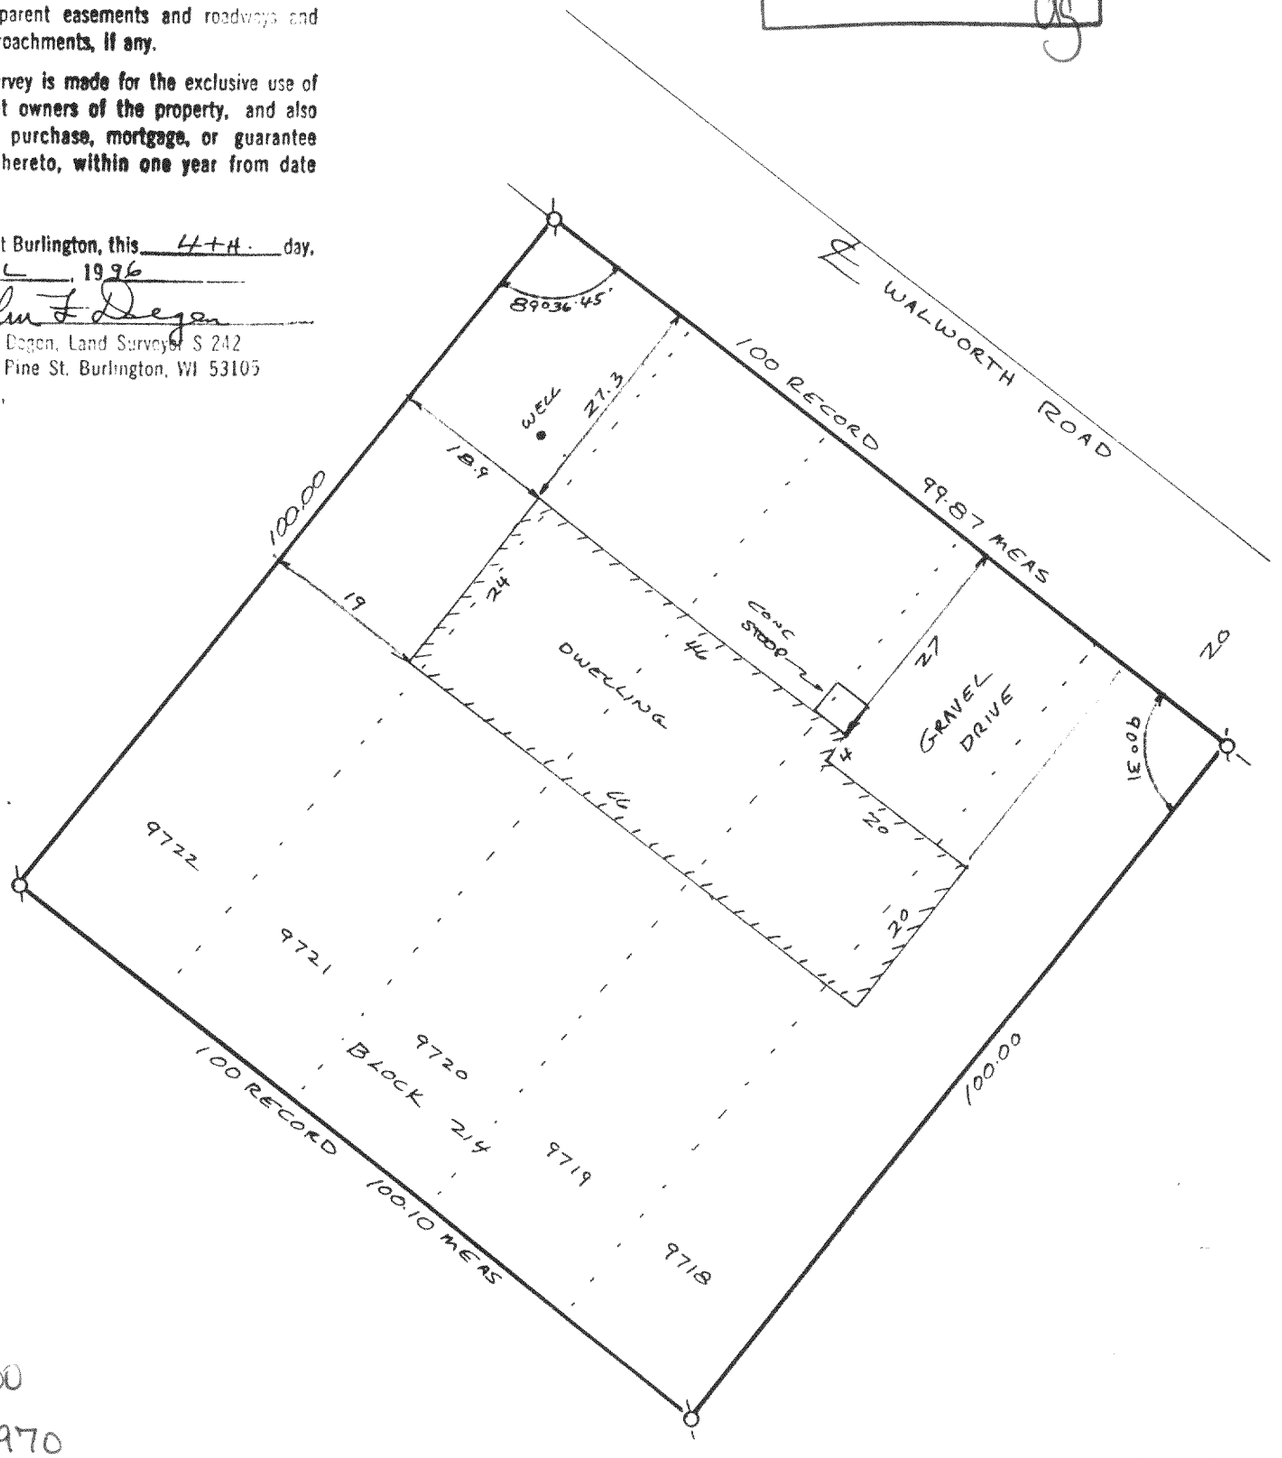

N

118-1500
MPL-1970

19-A #46