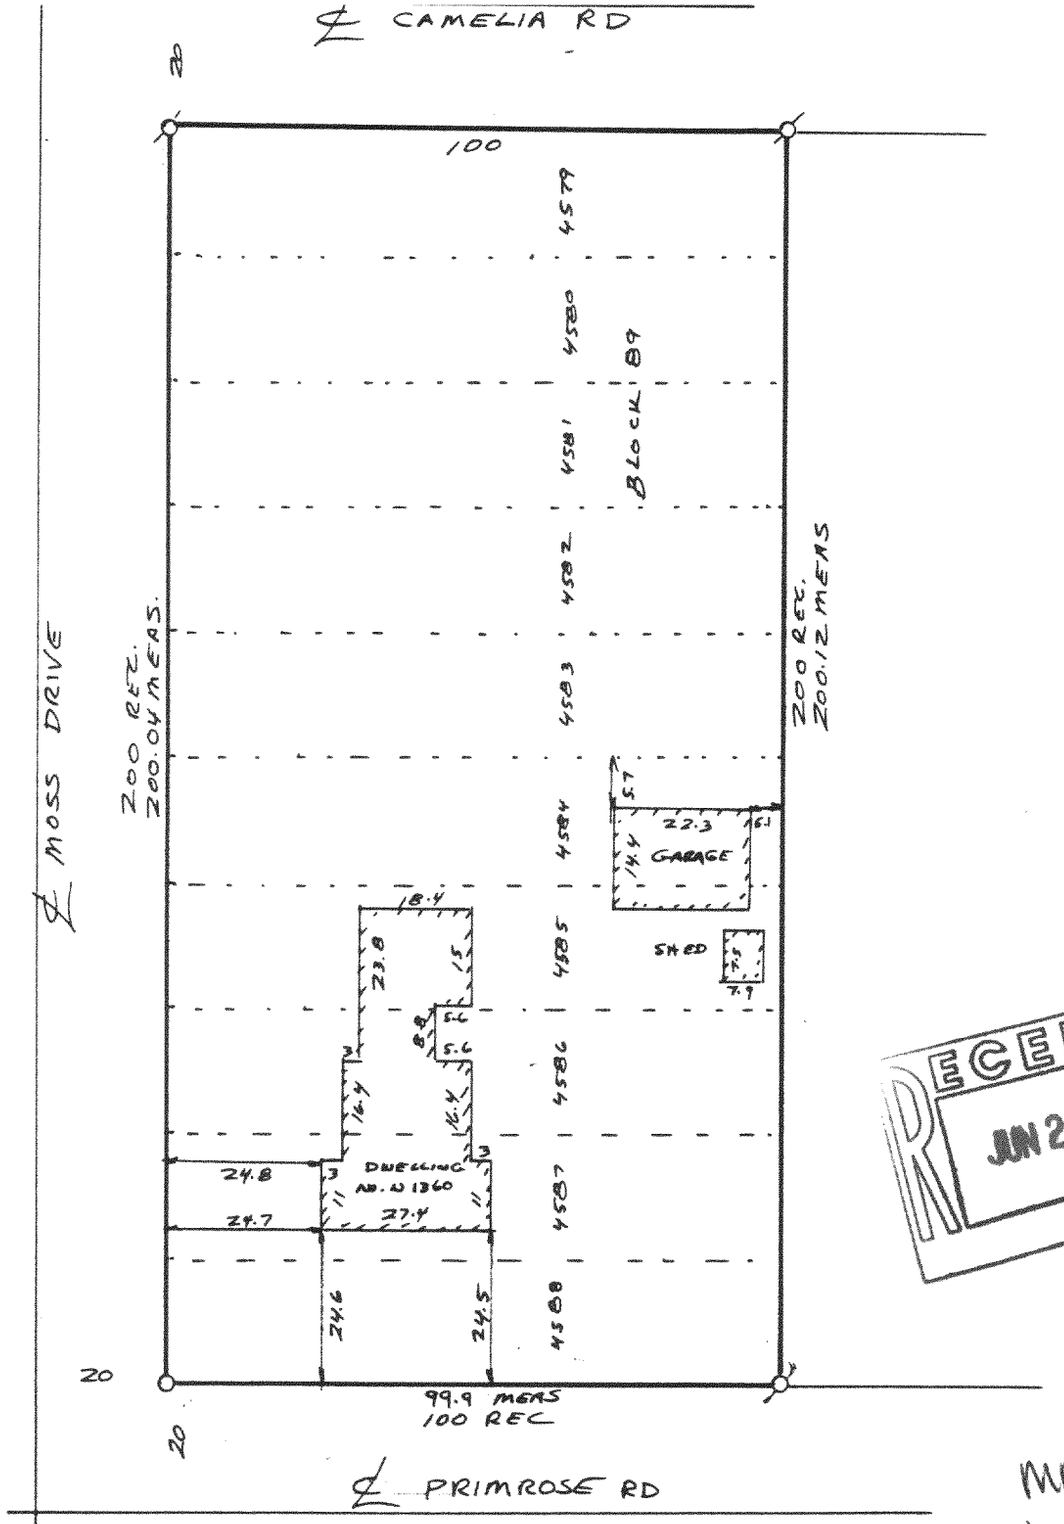

PLAT OF SURVEY
OF

LOTS 4579 THROUGH 4588 INCLUSIVE IN BLOCK 89 OF SECTION 3 OF PELL LAKE, A SUBDIVISION LOCATED IN THE TOWN OF BLOOMFIELD, WALWORTH COUNTY, WISCONSIN.

FOR: TRUESDALE SCALE 1" = 30'

ø = IRON PIPE FOUND. o = IRON PIPE SET.

I have surveyed the above-described property, and the map hereon is a true representation thereof and shows the size and location of the property, its exterior boundaries, the location and dimensions of all visible structures thereon, fences, apparent easements and roadways and visible encroachments, if any.

This survey is made for the exclusive use of the present owners of the property, and also those who purchase, mortgage, or guarantee the title thereto, within one year from date hereof.

Dated at Burlington, this 15TH day, of MAY 1996

John F. Degen

John F. Degen, Land Surveyor S 242
589 N. Pine St. Burlington, WI 53105

RECEIVED

MPL-979
118-1528

b# 1-4-11