AMBIT LAND SURVEYING
P. O. Box 42
Bassett, WI. 53101

P L A T O F S U R V E Y

O F

PHONE 414-537-4874
FAX 414-537-4221

Lots 3967 thru 3971, Block 80 of SECTION 3 PELL LAKE SUBDIVISION, being a subdivision of part of Section 15, Township 1 North, Range 18 East of the 4th Principal Meridian, Bloomfield Township, Walworth County, Wisconsin.

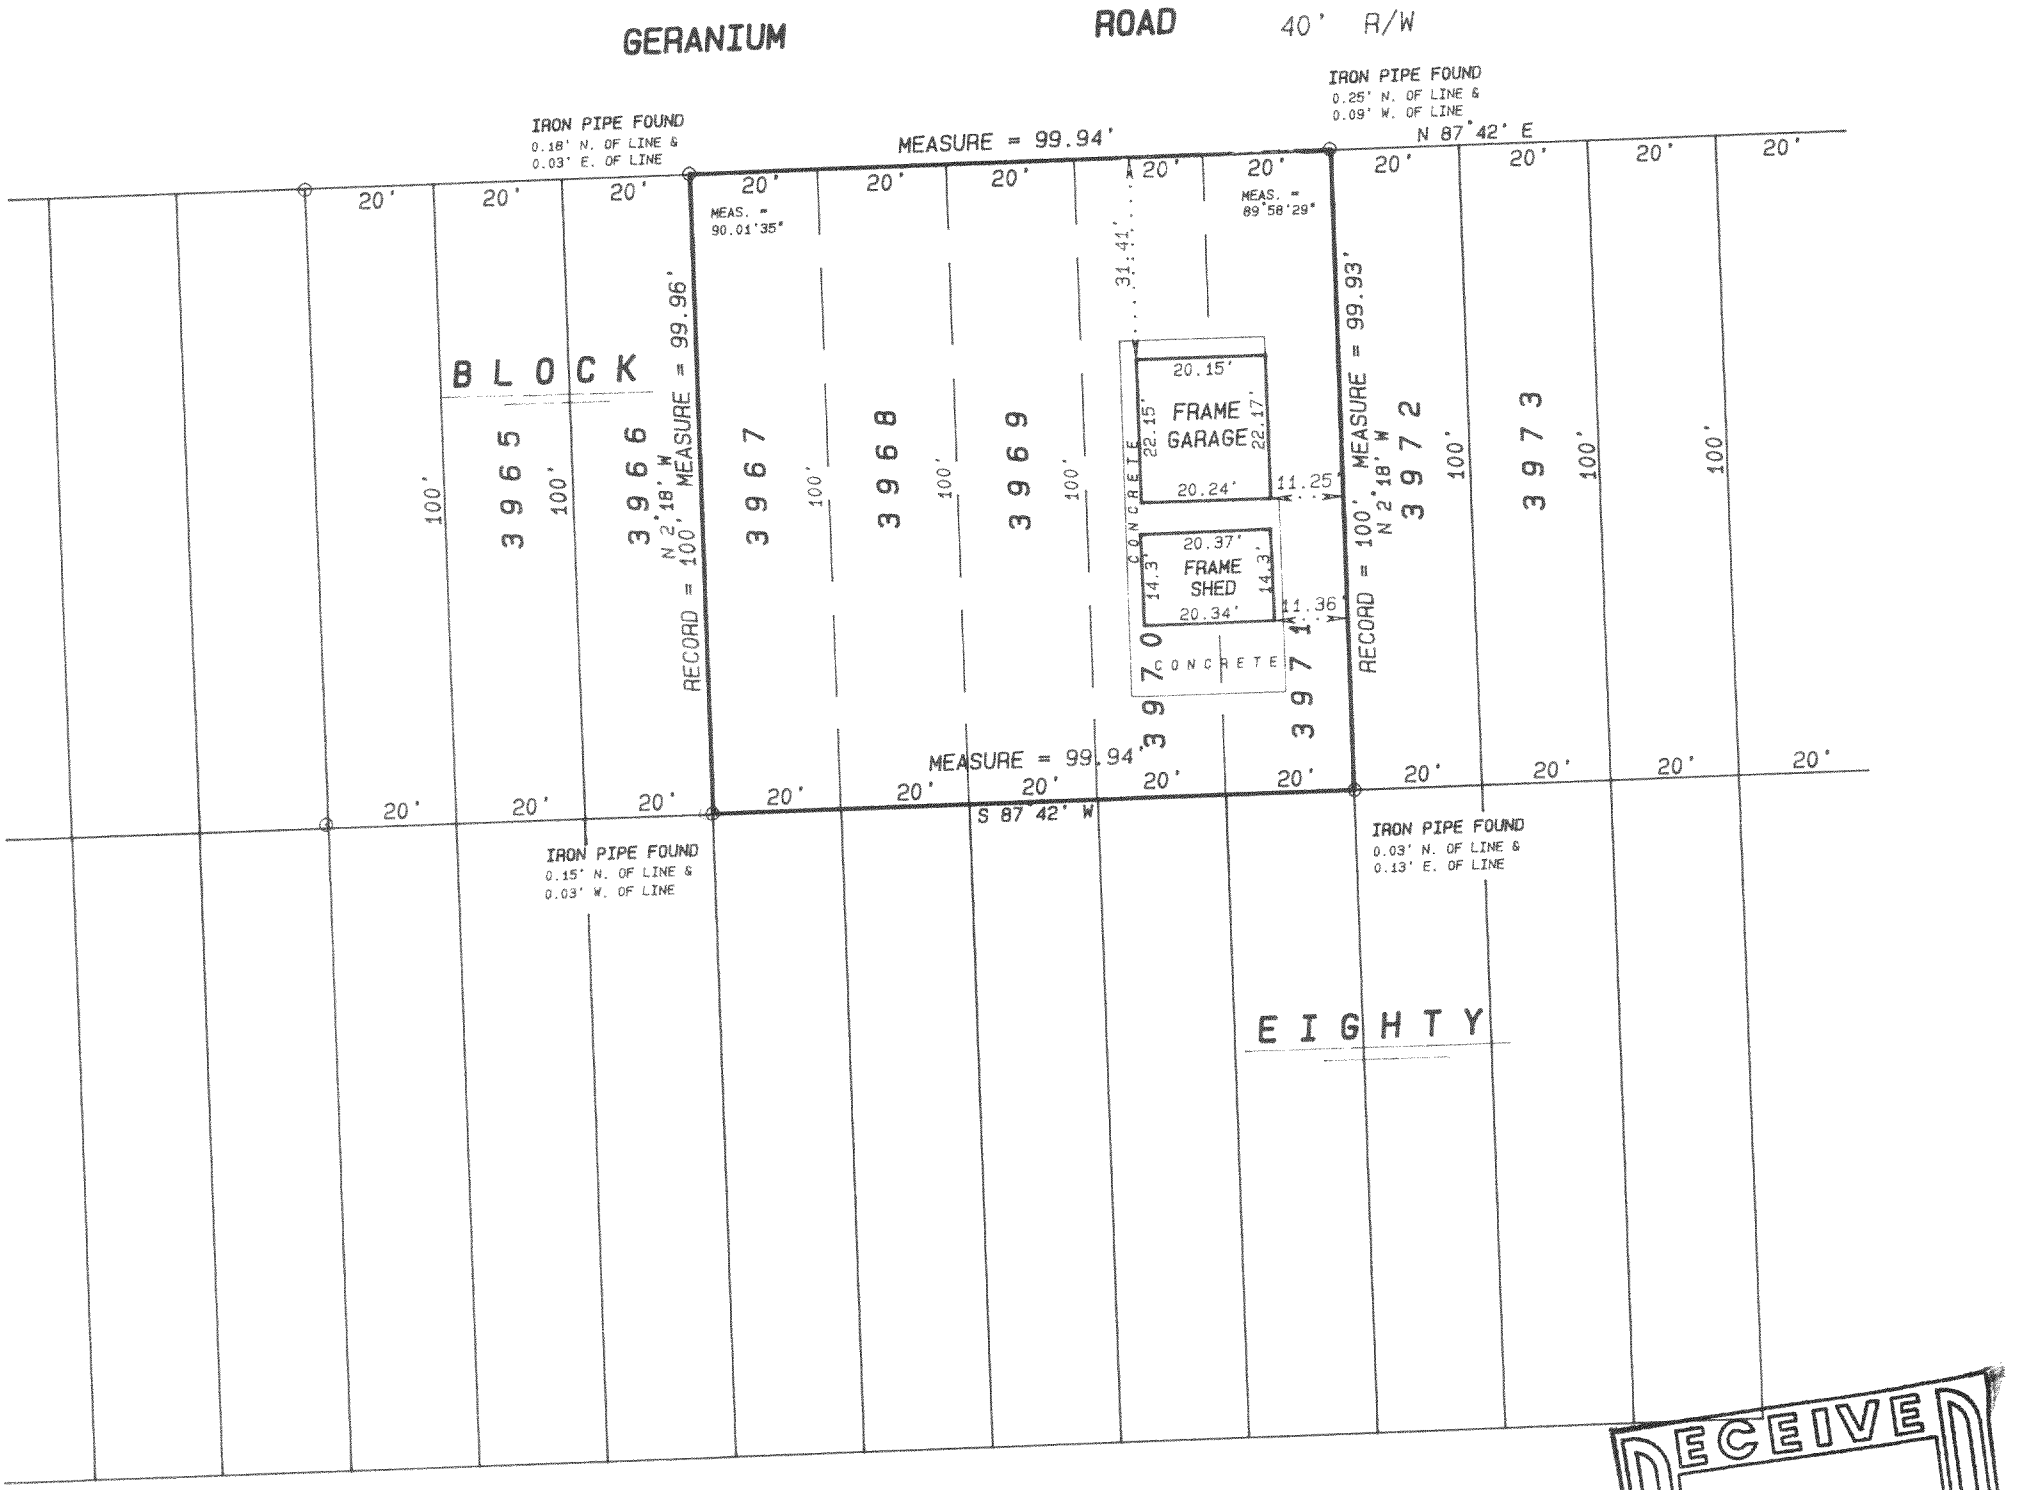

RECEIVED
MAY 28 1996

N

SCALE 1 inch = 30 feet
ORDERED BY A. Pierce / Pierce Construction
JOB NO. 95427

I hereby certify that I have surveyed the above described property and the above plat is a true representation thereof and shows the size and location of the property, its exterior boundaries, the location and dimensions of all visible structures thereon, boundary fences, apparent easements and roadways and visible encrochments, if any.

This survey is made for the exclusive use of the present owners of the property, and also those who purchase, mortgage, or guarantee the title thereto within one year from the date hereof.

Dated at Bassett, Wisconsin this _____ day of _____ 1996.

Mark A. Bolender
Wisconsin Registered Land Surveyor S - 1784

MPL-831
118-1538