PLAT OF SURVEY

PATHFINDER SURVEYING
929 WILLIAMS ST. LAKE GENEVA, WI.
(414) 248-3697

DATE: 6/28/1997

ORDERED BY : DEBBIE MILLER
ERA ACTION REALTY
204 N. LAKE AVE.
TWIN LAKES, WI. 53181


DESCRIPTION: LOTS 2487– 2492 INCLUSIVE, PELL LAKE SUBDIVISION, A SUBDIVSION LOCATED IN SECTION 22,, T.1.N. , R.18.E. , TOWN OF BLOOMFIELD, WALWORTH COUNTY, WISCONSIN.

OWNERS: GREGORY & ANNA KARPINSKI

LEGEND

- ⌀ FOUND 1 IN. IRON PIPE
- ⊙ FOUND 2 IN. IRON PIPE
- ● SET 1 IN. IRON PIPE
- —x— FENCE

SCALE 1" = 30'

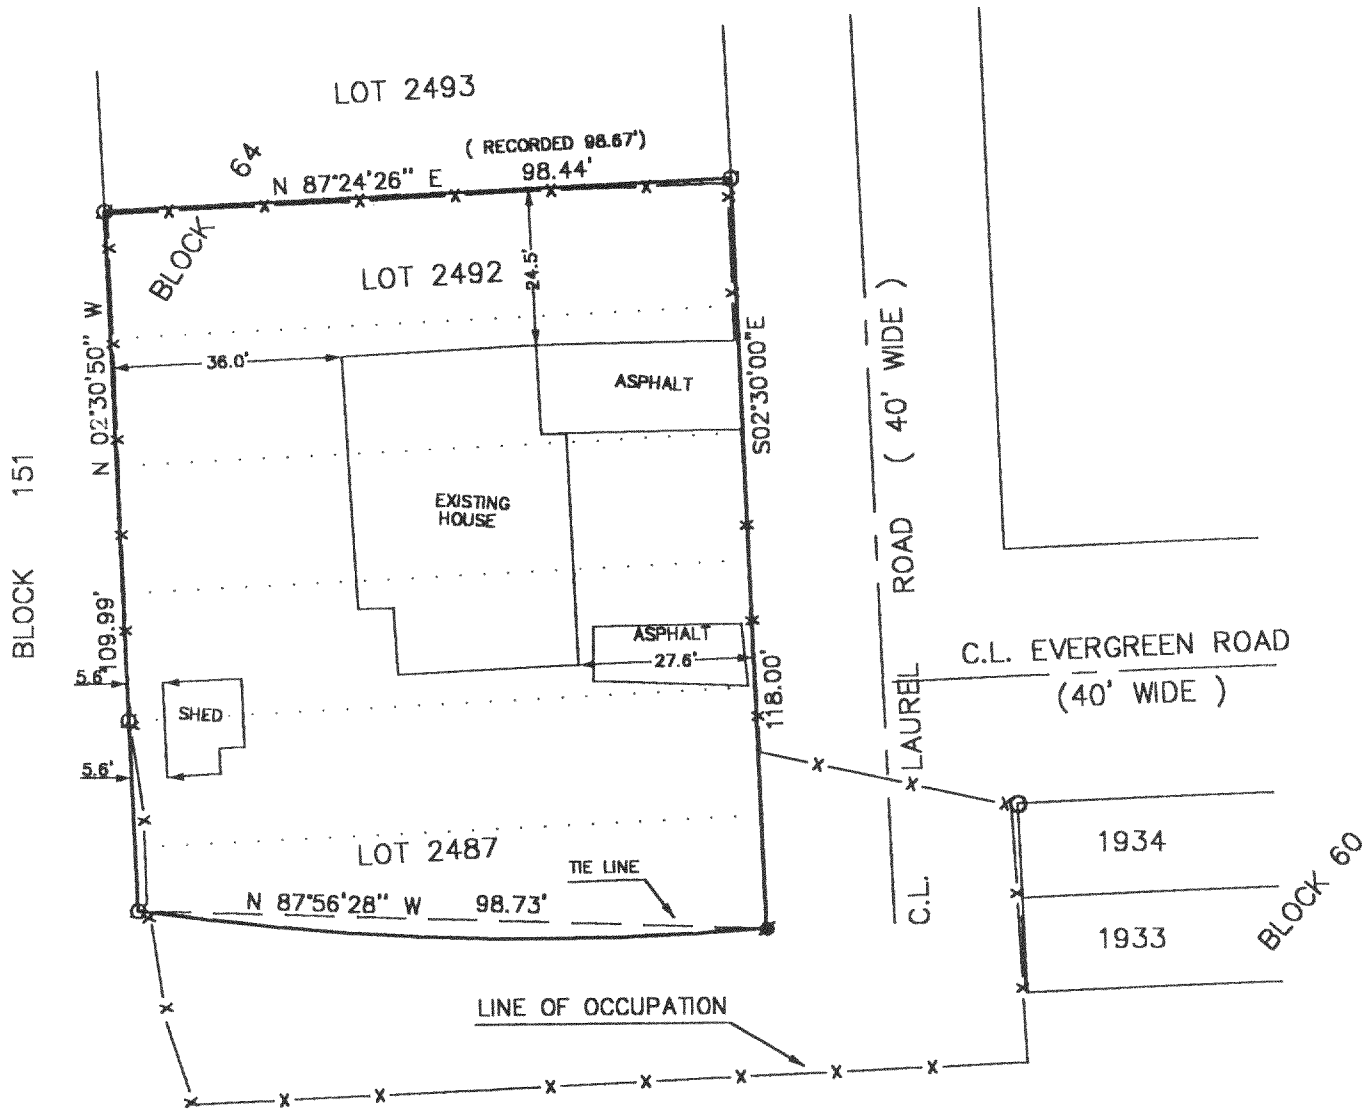

NOTE: BEARINGS REFERENCED TO RECORD PLAT OF PELL LAKE.

THE ABOVE MAP IS A TRUE REPRESENTATION THEREOF AND SHOWS THE SIZE AND LOCATION OF ALL THE PROPERTY, EXTERIOR BOUNDARIES, THE LOCATION OF ALL VISIBLE BOUNDARY FENCES , APPARENT EASEMENTS , ROADWAYS AND VISIBLE ENCROACHMENTS , IF ANY.

THIS SURVEY IS MADE FOR THE USE OF THE PRESENT OWNERS OF THE PROPERTY , AND ALSO THOSE WHO PURCHASE , MORTGAGE OR GURANTEE TITLE THERETO WITHIN ONE (1) YEAR FROM DATE HERETO.

WISCONSIN
JOHN P. KROTT
S-2258
MUKWONAGO, WIS.
LAND SURVEYOR

John P Krott
JOHN P. KROTT , R.L.S. 2258

RECEIVED
JUL 11 1997

NOTE: THIS IS NOT A CERTIFIED COPY UNLESS SEAL IS IN RED

JOB NUMBER 97037/MPL00517

MPL-517
118-1663