ABERNATHY and ASSOCIATES
Kenneth B. Abernathy Jr.
Wisconsin Registered Land Surveyor S-1594

W4056 Bray Road
Elkhorn, Wisconsin 53121
Phone: (414) 723-4260 (office)
(414) 723-7209 (fax)

PLAT OF SURVEY

Lots 4277, 4278, 4279, 4280, 4281, 4282, 4283, 4284, and 4285 of Block 85 of Pell Lake Subdivision 3rd Map, located in part of the Southeast 1/4 of Section 15, Town 1 North, Range 18 East, Town of Bloomfield, County of Walworth, State of Wisconsin.

NOTE
WOOD STAKES HAVE BEEN PLACED AT BUILDING CORNERS, BUILDER IS TO VERIFY DIMENSIONS WHICH HAVE BEEN ROUNDED TO THE NEAREST TENTH OF A FOOT TO INSURE PROPER PLAN INTERPRETATION AND CONTACT THIS OFFICE IMMEDIATELY IF ANY DISCREPANCY EXISTS.

RECEIVED
OCT 22 1997

Legend

- FOUND IRON PIPE
- FOUND IRON ROD
- FOUND BRASS CAPPED MONUMENT
- FOUND CONCRETE MONUMENT
- CHISEL CUT IN CONCRETE
- SET IRON ROD, 24" LONG, WEIGHING 1.5 LBS./LINEAL FT., 3/4" DIA.
- SET IRON ROD, 30" LONG, WEIGHING 4.5 LBS./LINEAL FT., 1-11/16" DIA.
- (xx) RECORDED AS DIMENSION
- —x— EXISTING FENCE

WISCONSIN
KENNETH B. ABERNATHY, JR.
S-1594
ELKHORN, WI
LAND SURVEYOR

N

SCALE: 1" = 10 FEET

I hereby certify that the above described property has been surveyed by me or under my direction and that the above map is a true representation thereof and shows the size and location of the property, its exterior boundaries, the location of all visible structures and dimensions of all principal buildings thereon, boundary fences, apparent easements, roadways and visible encroachments, if any.
This survey is made for the use of the present owners of the property, and also those who purchase, mortgage, or guarantee the title thereto within one year from date hereof.

KENNETH B. ABERNATHY, JR.
WISCONSIN REGISTERED LAND SURVEYOR,
S-1594
Date: September 5, 1997 Job No. 1997.819

Owners: Richard & Caroline Stromich
Post Office Box 30
Pell Lake, Wisconsin 53157

Ordered by: Brandt Schauder
Schauder Building, Inc.
4115 Highway 51 North
Janesville, Wisconsin 53545-9674

ABERNATHY and ASSOCIATES
Kenneth B. Abernathy Jr.
Wisconsin Registered Land Surveyor S-1594

W4056 Bray Road
Elkhorn, Wisconsin 53121
Phone: (414) 723-4260 (office)
(414) 723-7209 (fax)

PLAT OF SURVEY

Lots 4277, 4278, 4279, 4280, 4281, 4282, 4283, 4284, and 4285 of Block 85 of Pell Lake Subdivision 3rd Map, located in part of the Southeast 1/4 of Section 15, Town 1 North, Range 18 East, Town of Bloomfield, County of Walworth, State of Wisconsin.

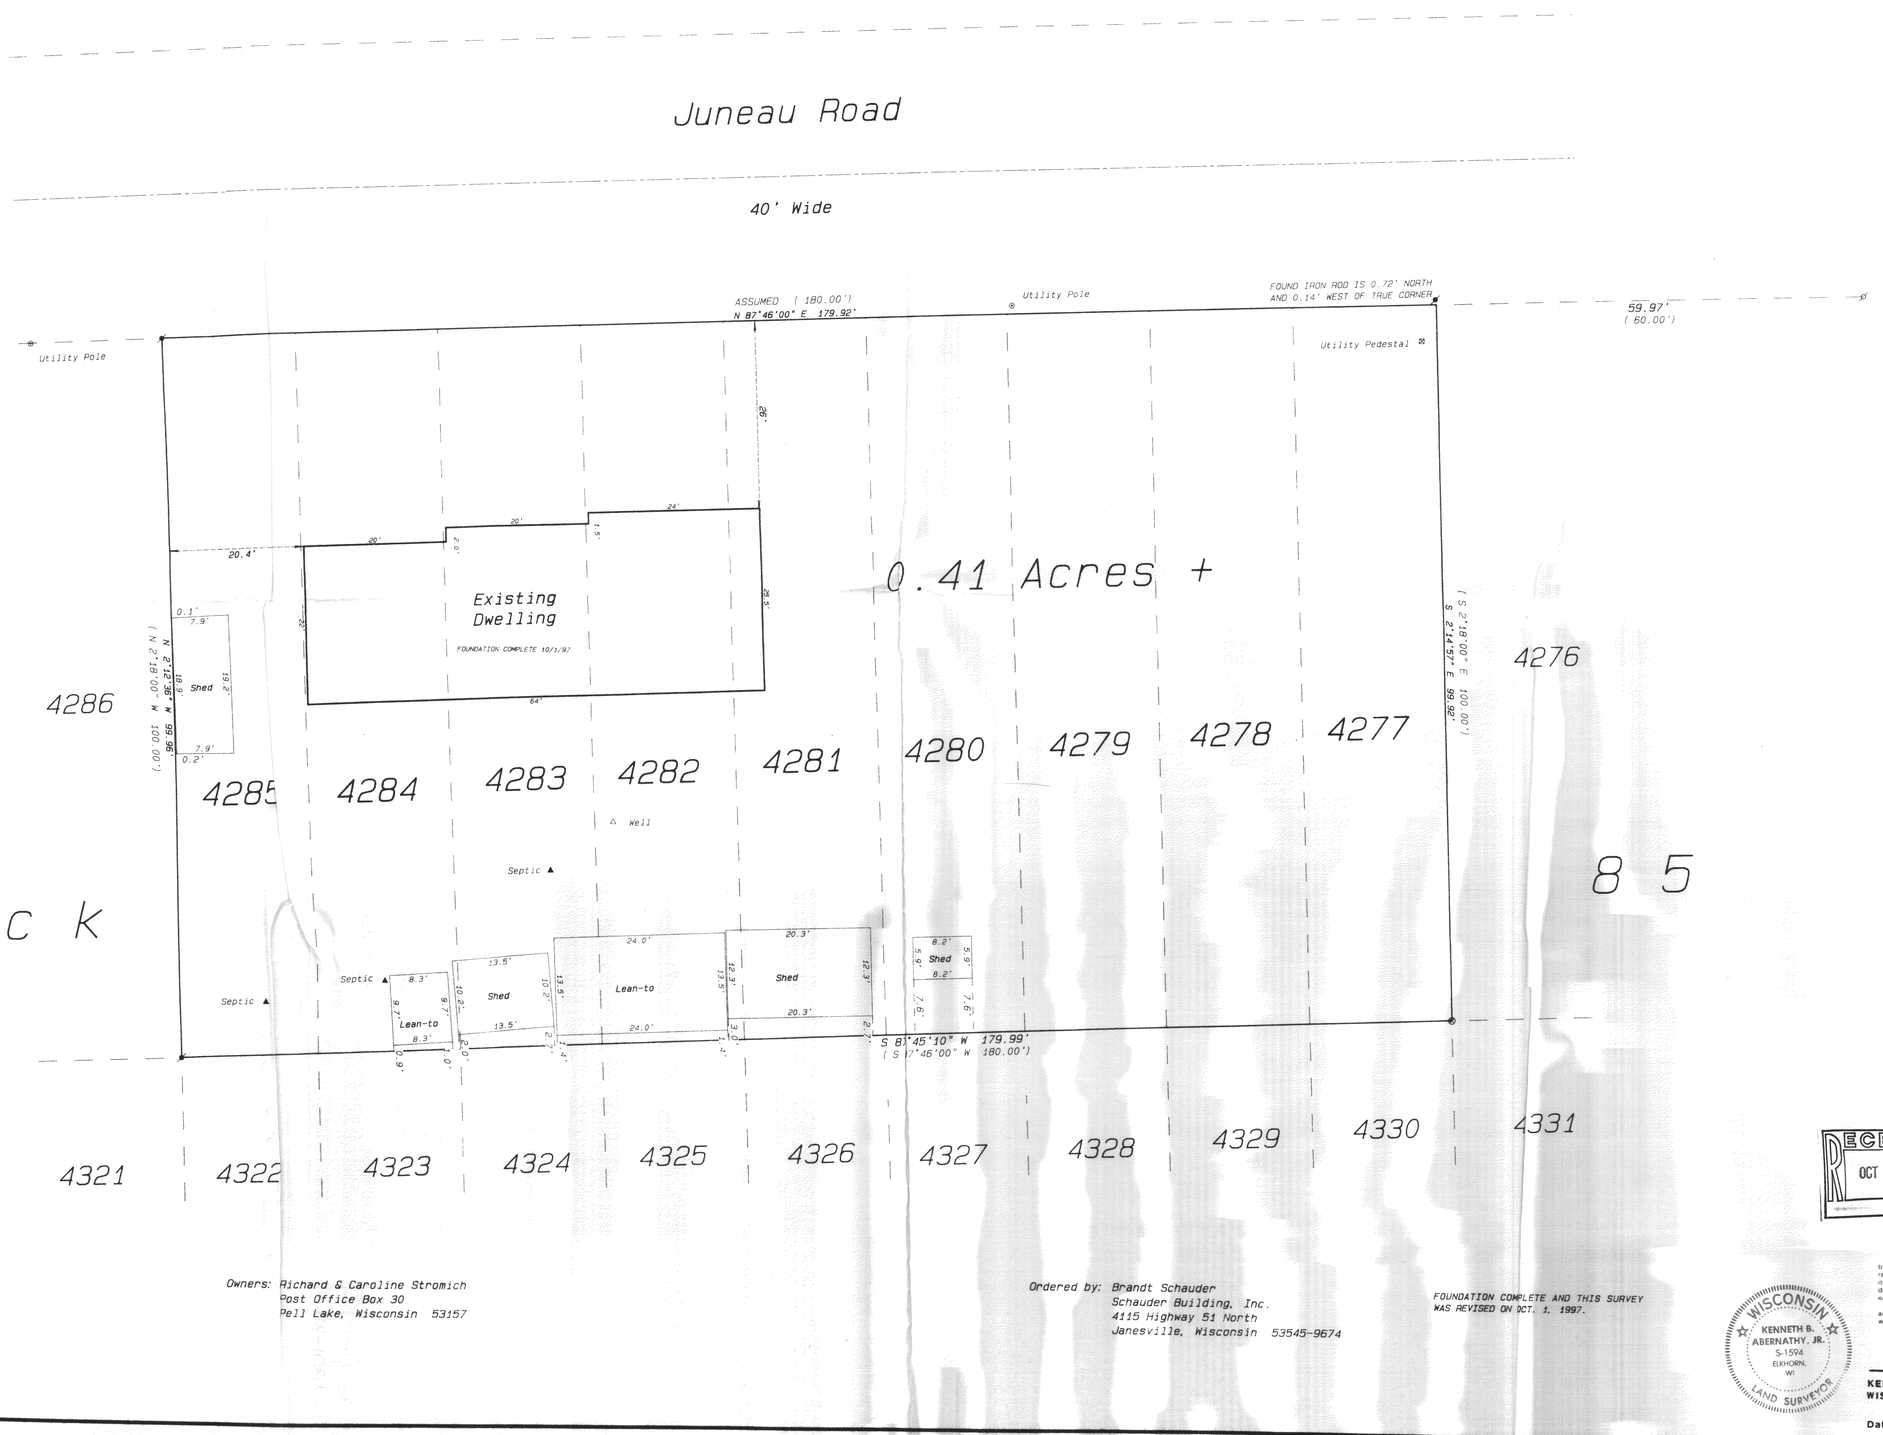

Owners: Richard & Caroline Stromich
Post Office Box 30
Pell Lake, Wisconsin 53157

Ordered by: Brandt Schauder
Schauder Building, Inc.
4115 Highway 51 North
Janesville, Wisconsin 53545-9674

FOUNDATION COMPLETE AND THIS SURVEY WAS REVISED ON OCT. 1, 1997.

Legend

- FOUND IRON PIPE
- FOUND IRON ROD
- FOUND BRASS CAPPED MONUMENT
- FOUND CONCRETE MONUMENT
- CHISEL CUT IN CONCRETE
- SET IRON ROD, 24" LONG, WEIGHING 1.5 LBS./LINEAL FT., 3/4" DIA.
- SET IRON ROD, 30" LONG, WEIGHING 4.5 LBS./LINEAL FT., 1.11/16" DIA.
- (xx) RECORDED AS DIMENSION
- EXISTING FENCE

RECEIVED
OCT 22 1997

SCALE: 1" = 10 FEET

I hereby certify that the above described property has been surveyed by me or under my direction and that the above map is a true representation thereof and shows the size and location of the property, its exterior boundaries, the location of all visible structures and dimensions of all principal buildings thereon, boundary fences, apparent easements, roadways and visible encroachments, if any.
This survey is made for the use of the present owners of the property and also those who purchase, mortgage, or guarantee the title thereto within one year from date hereof.

WISCONSIN KENNETH B. ABERNATHY, JR. S-1594 ELKHORN, WI LAND SURVEYOR

KENNETH B. ABERNATHY, JR.
WISCONSIN REGISTERED LAND SURVEYOR, S-1594

Date: September 5, 1997 Job No. 1997.819

MPI-907 118-1487