PLAT OF SURVEY

PATHFINDER SURVEYING
FORMERLY KOLB LAND CONSULTING
929 WILLIAMS ST. LAKE GENEVA, WI.
(414) 248-3697

ORDERED BY : DENNIS UNBEHAUN
N.1945 N. DAISY DR
GENOA CITY, WI. 53128

DATE: 8\20\1998

DESCRIPTION: LOTS 1444-1447 INCLUSIVE BLOCK 32, PELL LAKE SUBDIVISON, T 1 N, R 18 E, WALWORTH COUNTY, WISCONSIN

LEGEND

- ○ FOUND IRON PIPE
- —X— FENCE
- ⊙ MAN HOLE
- (XXX) RECORDED AS

N

SCALE 1"=30'

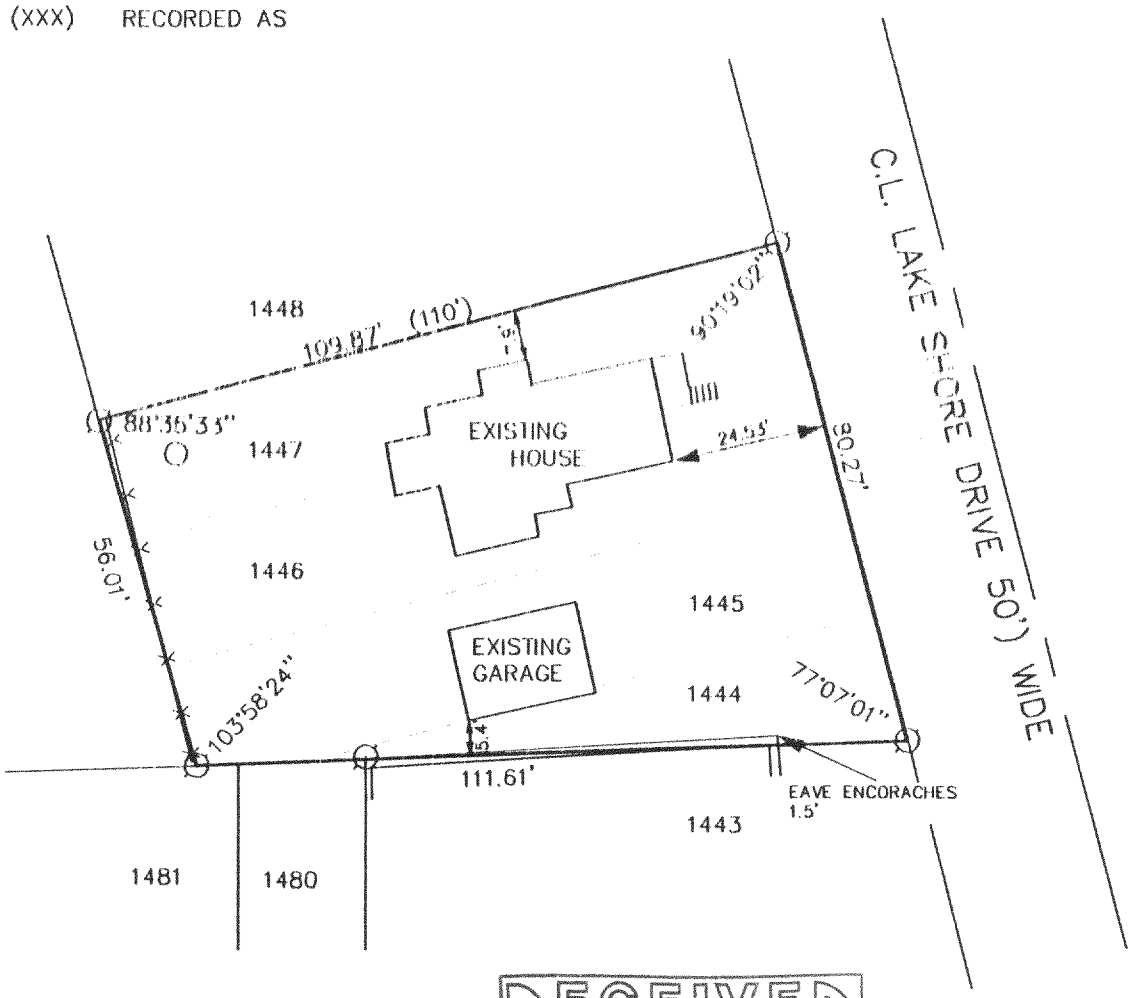

RECEIVED
SEP 1 1 1998

THE ABOVE MAP IS A TRUE REPRESENTATION THEREOF AND SHOWS THE SIZE AND LOCATION OF ALL THE PROPERTY, EXTERIOR BOUNDARIES, THE LOCATION OF ALL VISIBLE BOUNDARY FENCES , APPARENT EASEMENTS , ROADWAYS AND VISIBLE ENCROACHMENTS , IF ANY.

THIS SURVEY IS MADE FOR THE USE OF THE PRESENT OWNERS OF THE PROPERTY , AND ALSO THOSE WHO PURCHASE , MORTGAGE OR GURANTEE TITLE THERETO WITHIN ONE (1) YEAR FROM DATE HERETO.

WISCONSIN
JOHN P. KROTT
S-2258
MUKWONAGO, WIS.
LAND SURVEYOR

John P Krott

JOHN P. KROTT , R.L.S. 2258

NOTE: THIS IS NOT A CERTIFIED COPY UNLESS SEAL IS IN RED.
JOB NUMBER #98145 1-18-MPL-317

MPL-317 118-1753