PLAT OF SURVEY

- OF -

LOTS 5547 - 5557, BLOCK 101 PELL LAKE SUBDIVISION, SECTION 3, TOWN 1 NORTH, RANGE 18 EAST, WALWORTH COUNTY, WISCONSIN.

J.K. SURVEYING
JEFFREY L. KIMPS R.L.S.
7561 336TH AVE
BURLINGT0N WI. 53105
262-537-4274

PREPARED FOR : JAY KRASNE
REMAX ADVANTAGE
ANTIOCH ILL.

PROPERTY ADDRESS :
W1058 JUNEAU

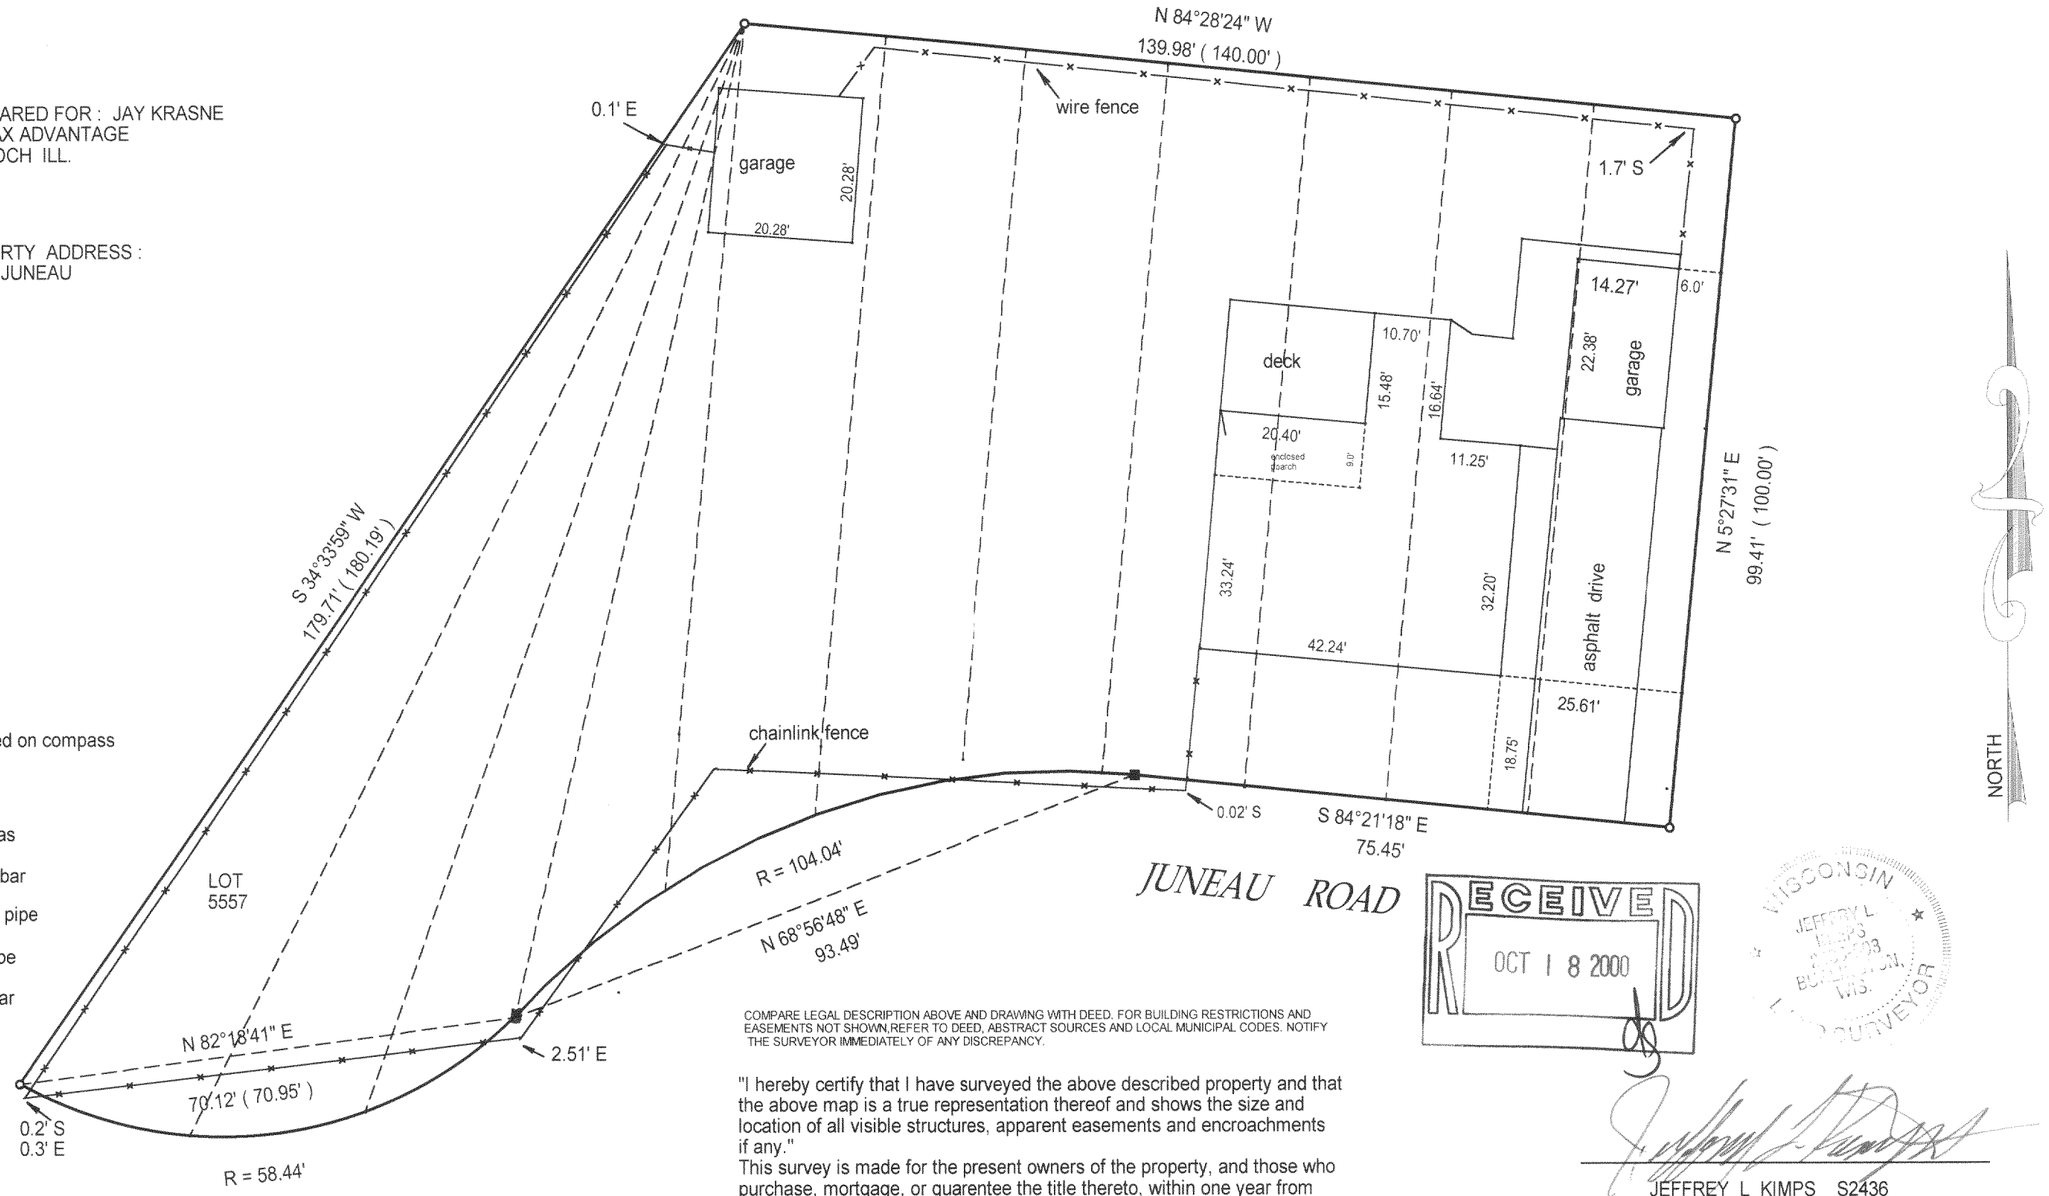

* bearings based on compass direction

( )= recorded as

□ = found iron bar

○ = found iron pipe

● = set iron pipe

■ = set iron bar

SCALE 1" =

JOB #

TAX ID #

COMPARE LEGAL DESCRIPTION ABOVE AND DRAWING WITH DEED. FOR BUILDING RESTRICTIONS AND EASEMENTS NOT SHOWN,REFER TO DEED, ABSTRACT SOURCES AND LOCAL MUNICIPAL CODES. NOTIFY THE SURVEYOR IMMEDIATELY OF ANY DISCREPANCY.

"I hereby certify that I have surveyed the above described property and that the above map is a true representation thereof and shows the size and location of all visible structures, apparent easements and encroachments if any."
This survey is made for the present owners of the property, and those who purchase, mortgage, or guarentee the title thereto, within one year from the date hereof. DATED THIS _____TH, DAY OF _____ 20 _____.

RECEIVED
OCT 1 8 2000

WISCONSIN
JEFFREY L
KIMPS
S-2436
BURLINGTON, WI.
SURVEYOR

JEFFREY L KIMPS S2436
(original if signed in red)

MPL-1200

118-1968