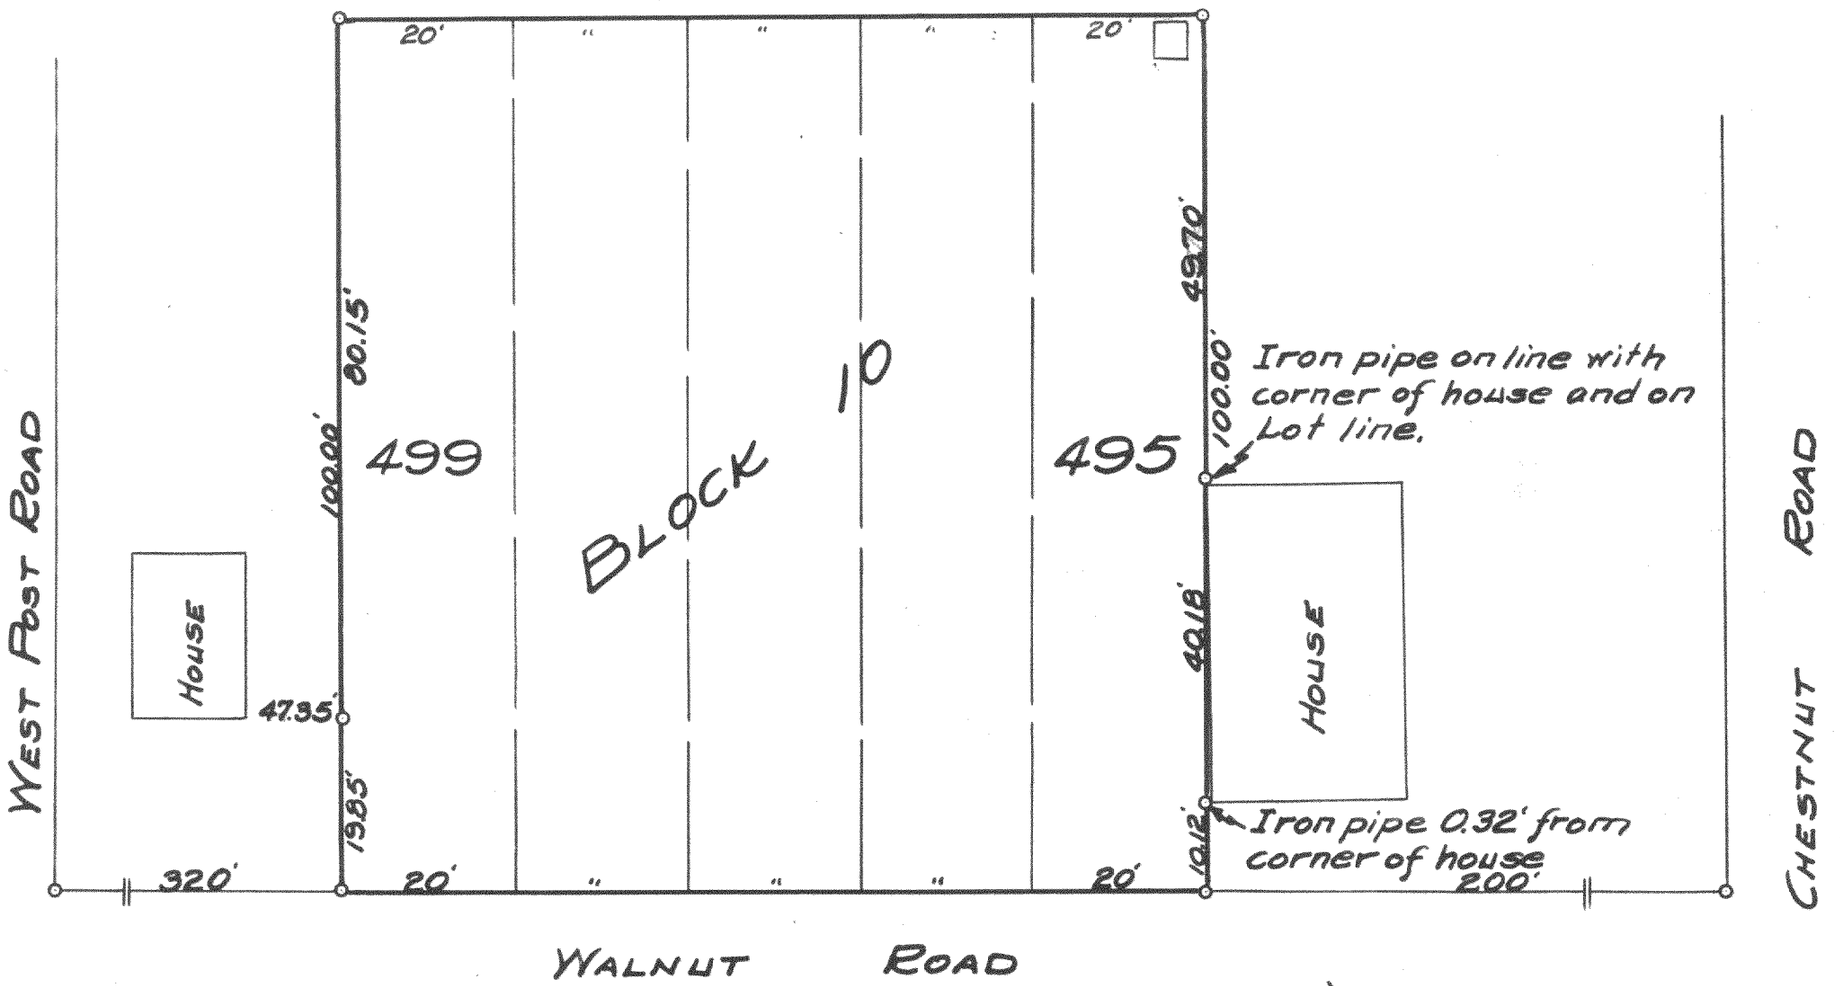

Plat of a survey of Lots 495 to 499 Sect. 2
of Block 10, of PELL LAKE SUBDIVISION,
Walworth County, Wisconsin.
Scale 1" = 20'
Feb. 2, 1935
○-Iron Pipe

Surveyed by Floyd S. Jensen
County Surveyor

118-2